


T.35 S.R.2W.W.M.

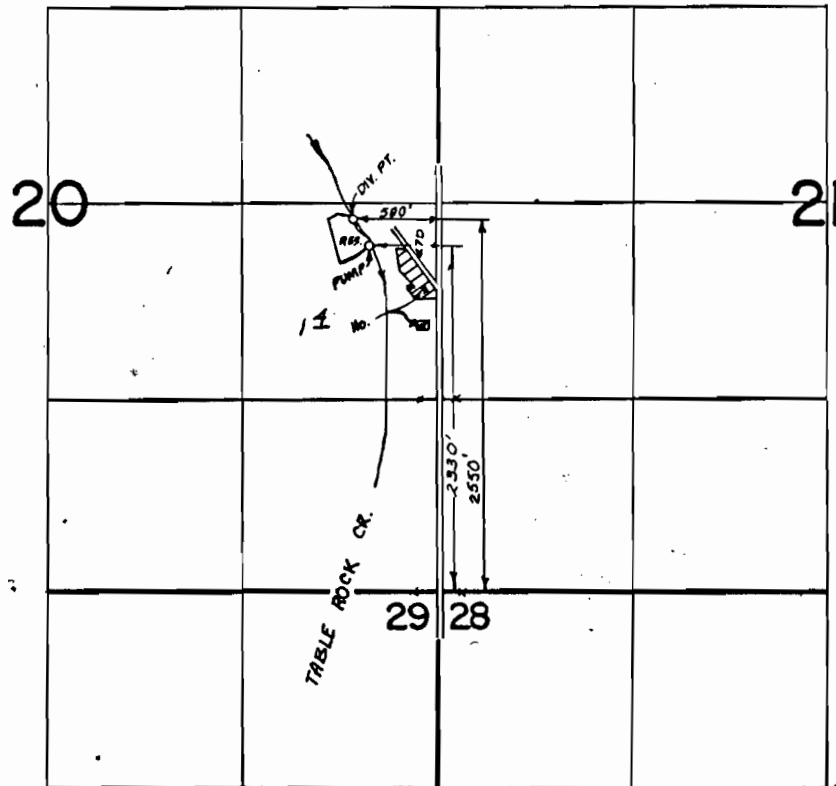

FINAL PROOF SURVEY
UNDER

R-44806 R-5293
Application No. 44807 Permit No. 33514
IN NAME OF

JESSIE L. BERKHEIMER

Surveyed OCT. 17, 1973, by R.G. MUCKEN