


T. 35 S. R. 2 W. W.M.

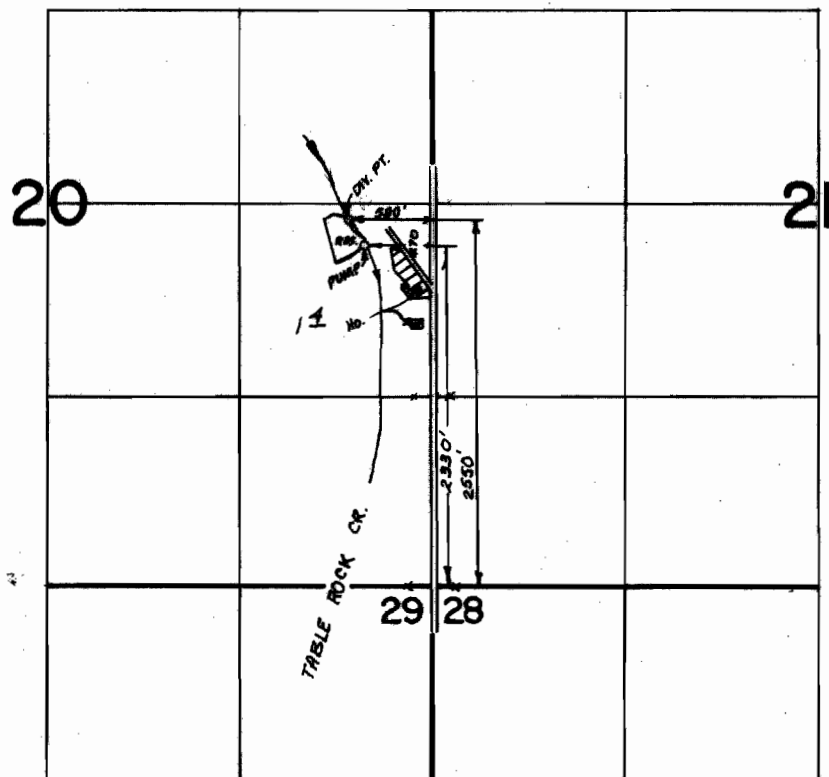

FINAL PROOF SURVEY
UNDER

R-44806 R-5293
Application No. 44807 Permit No. 33514
IN NAME OF

JESSIE L. BERKHEIMER

Surveyed OCT 17 19 73 by R.G. MUCKEN