


T.15S., R.4W., W.M.

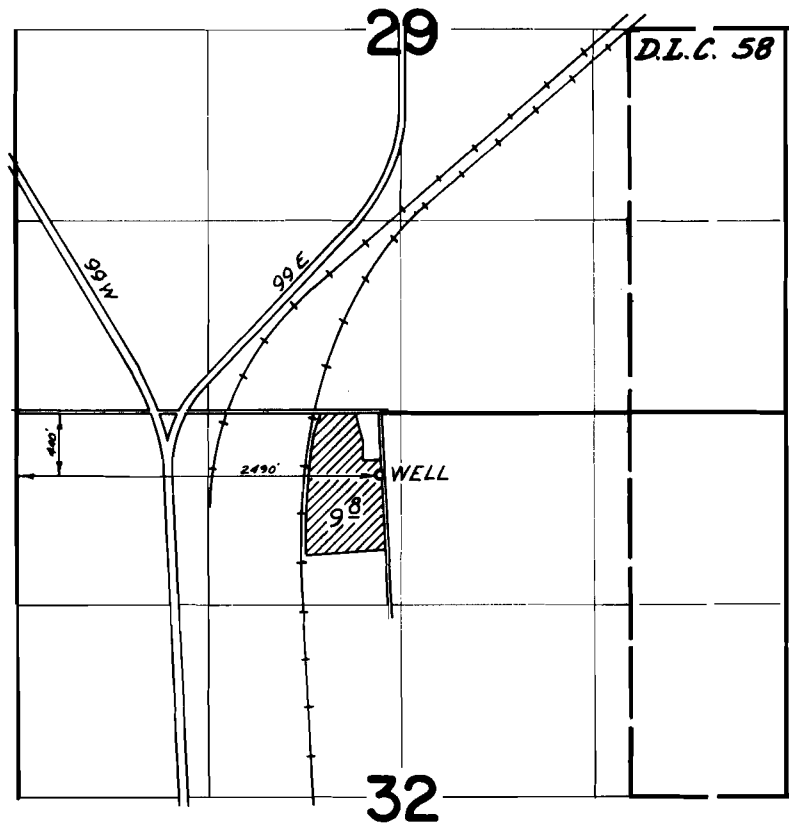

FINAL PROOF SURVEY
UNDER

Application No. G-5187 Permit No. G-5057
IN NAME OF

ROY V. SOGAARD

Surveyed Sept 20 1970, by D. Noeby