


T. 18 S. R. 12 W. W.M.

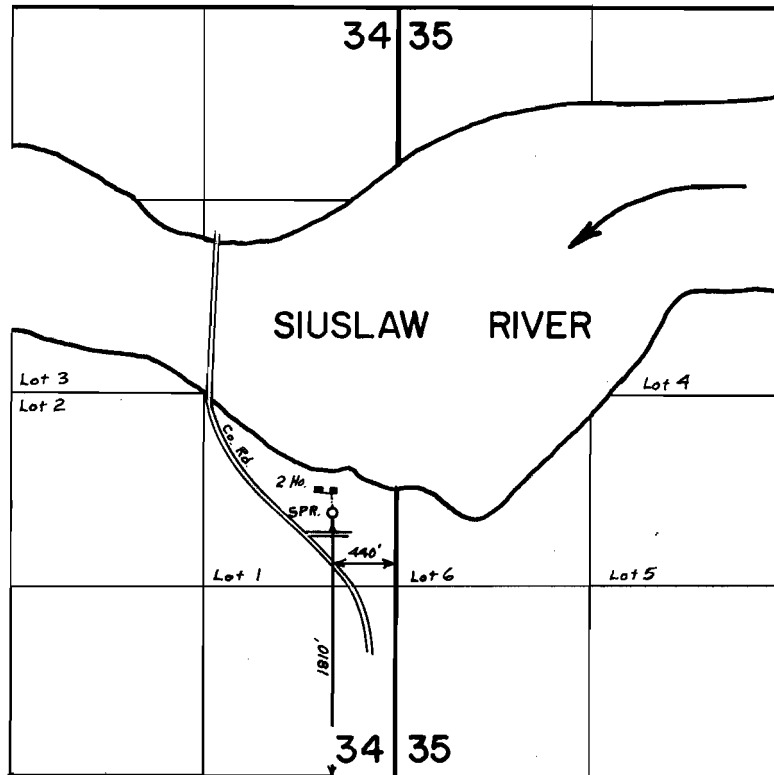

FINAL PROOF SURVEY
UNDER

Application No. 40281 Permit No. 30260
IN NAME OF

LESTER R. & LOUISE M. NORDAHL

Surveyed JUL 18 19 73, by L.E. GOULD