


T.16&17S.R.2&3E.W.M.

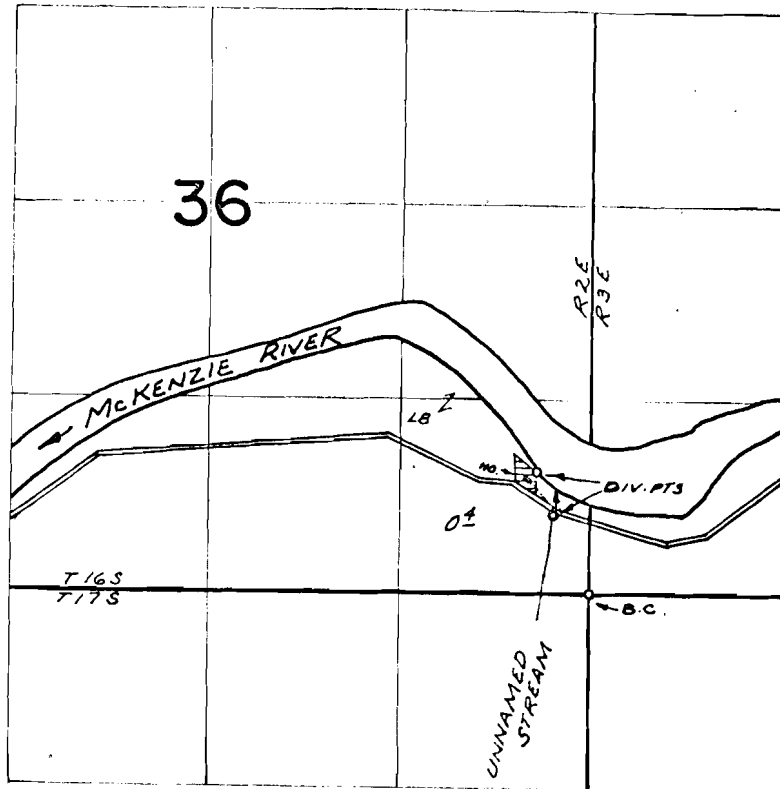

DIV. PTS. LOC: UNN. STR. - 530' N E 250' W; RIVER - 820' N E 370' W, BOTH FROM S.E. COR. SEC. 36

FINAL PROOF SURVEY
UNDER

Application No. 45077 Permit No. 33953
41923 31381
IN NAME OF

COBURN HASKELL

Surveyed SEPT. 28, 1973, by R. MURKEN