


T.17S., R.3W., W.M.

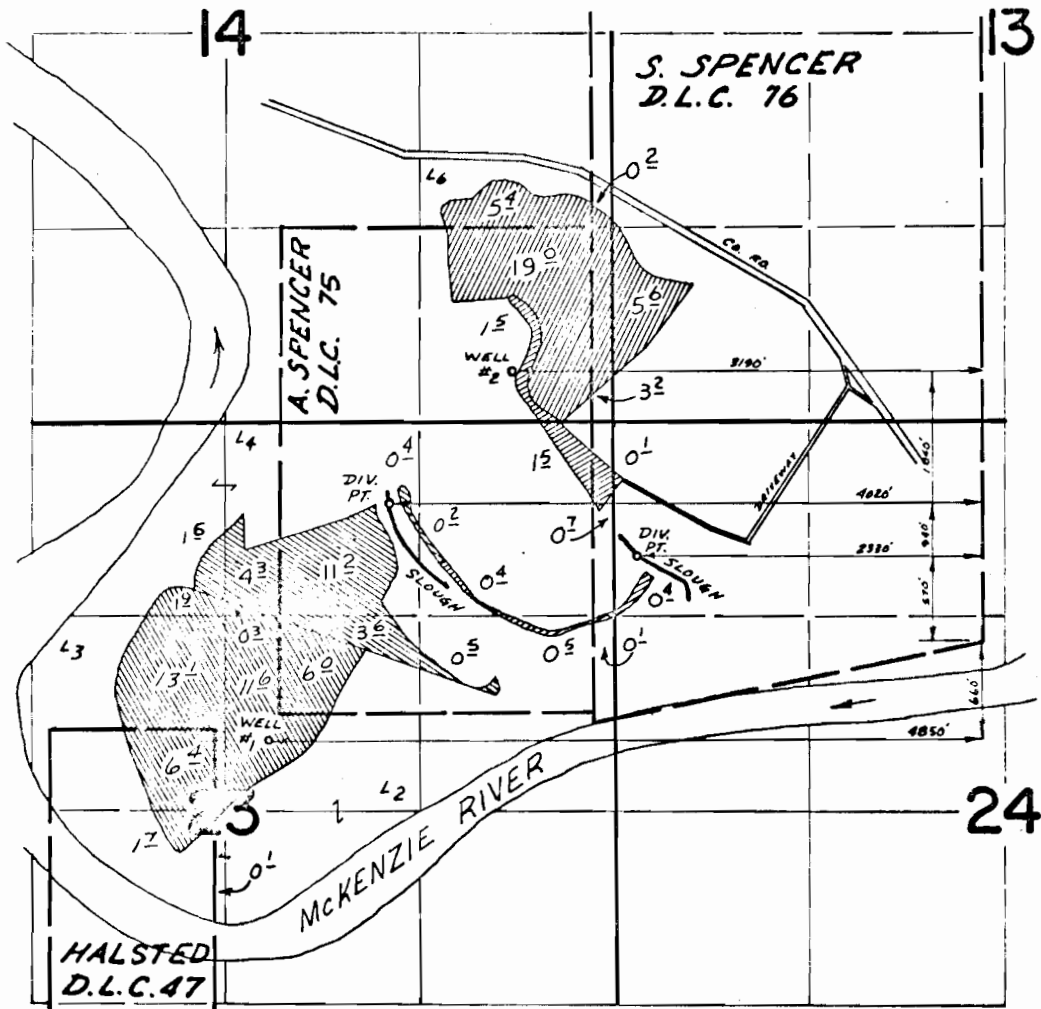

FINAL PROOF SURVEY
UNDER

G-3568

G-3363

Application No. 42465 Permit No. 31761
IN NAME OF

JOHN E. JAQUA

Surveyed June 11, 1973, by D. NORBY

