


T. 19 S. R. 11 W. W.M.

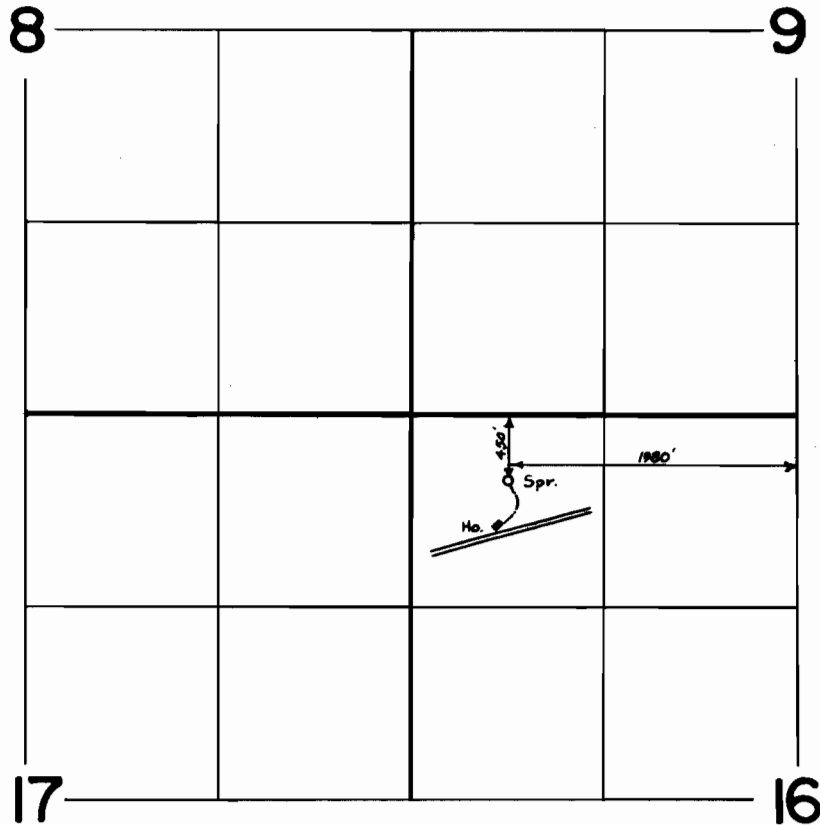

FINAL PROOF SURVEY
UNDER

Application No. 45067 Permit No. 33203
IN NAME OF

HAROLD WAYNE BOLLENBAUGH

Surveyed JULY 19 1973, by L.E. GOULD