


T.15S., R.5W., W.M.

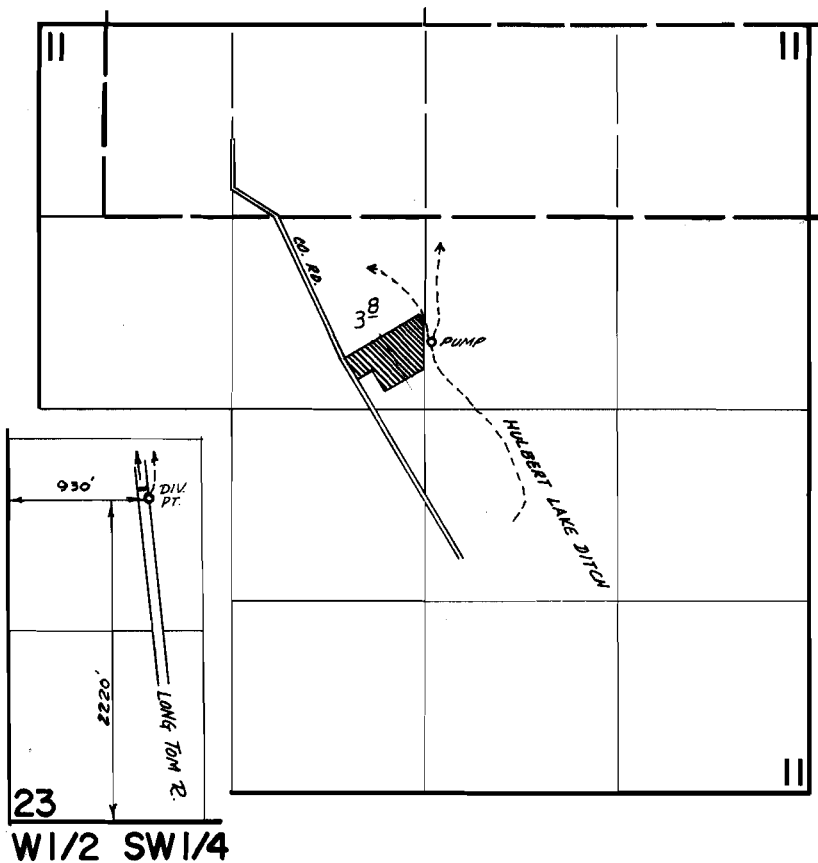

FINAL PROOF SURVEY
UNDER

Application No. 44566 Permit No. 33357
IN NAME OF

ROBERT L. GREER

Surveyed Sept 20 1973, by D. NORBY