


T.16S.R.2E.W.M.

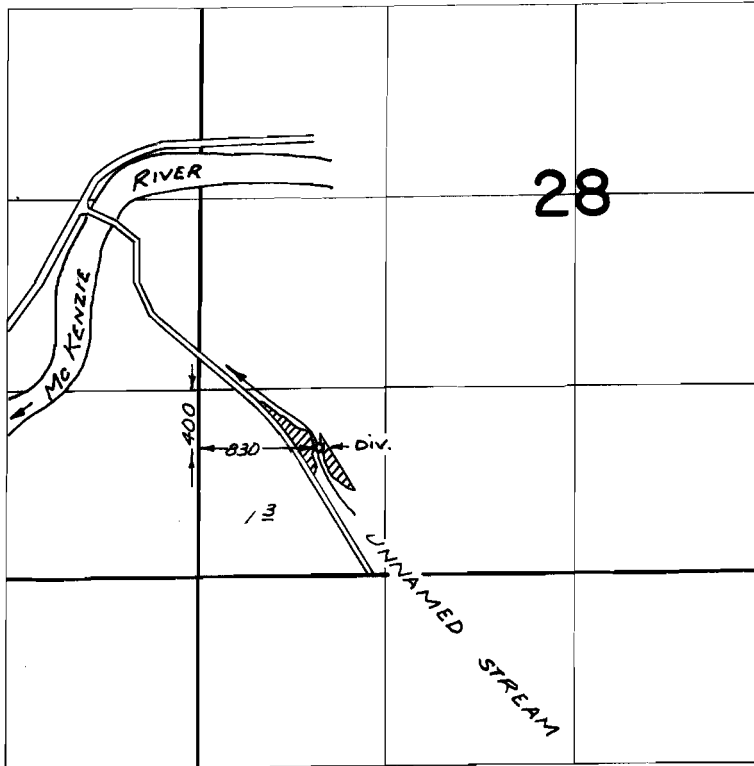

FINAL PROOF SURVEY
UNDER

Application No. 44705 Permit No. 33471
IN NAME OF

AUGUST J. RODAKOWSKI

Surveyed SEPT. 4, 1973, by R. MUCKEN