


T.18S., R.5W., W.M.

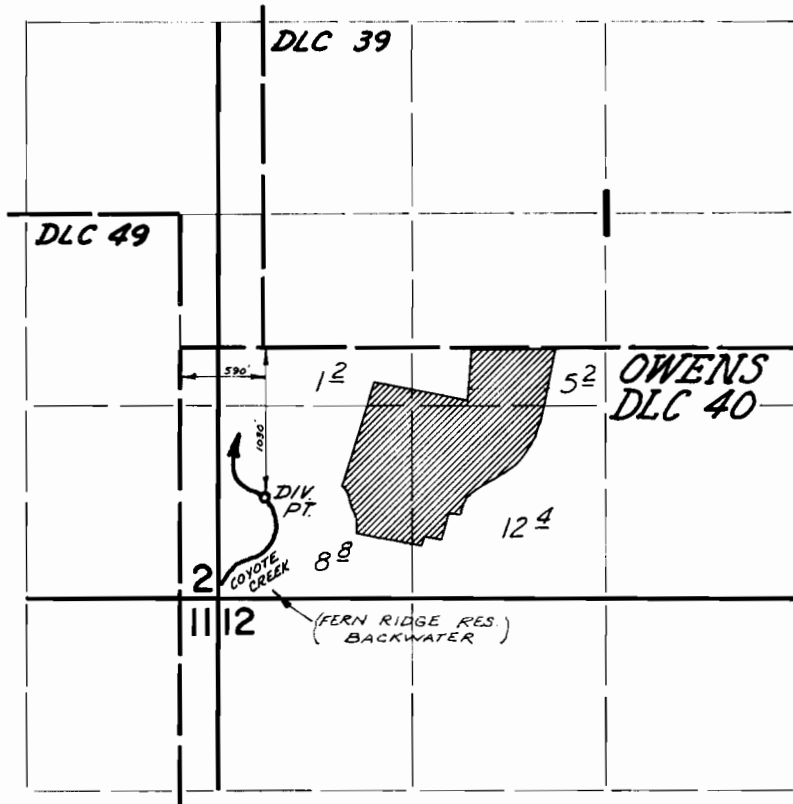

FINAL PROOF SURVEY
UNDER

Application No. 44958 Permit No. 33603
IN NAME OF

JAMES C. TAPP

Surveyed June 15 1973, by D. Norby