


T.17S.R.2W.W.M.

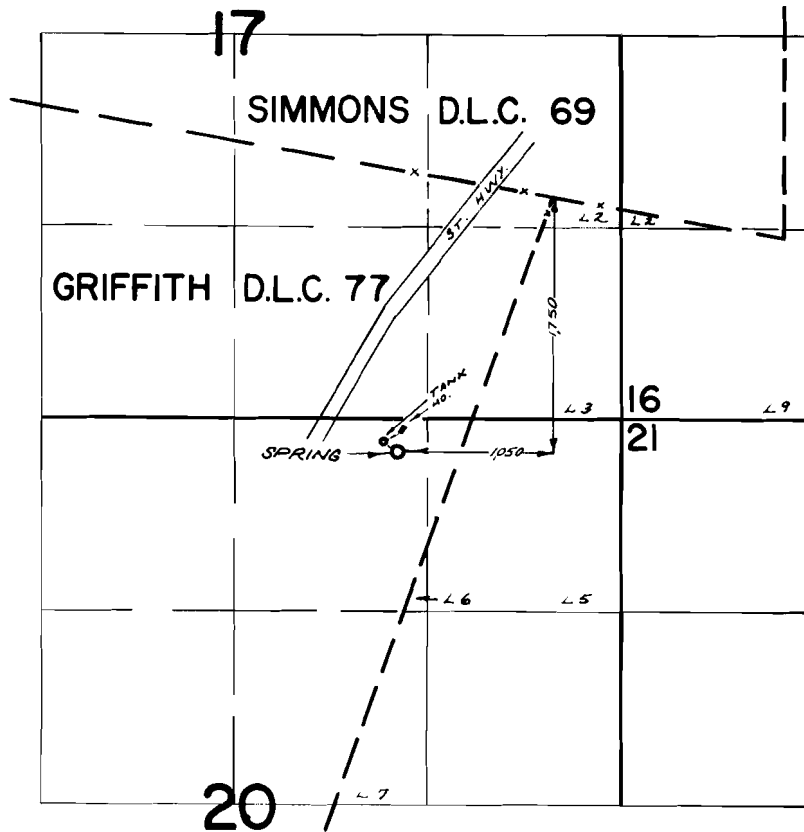

FINAL PROOF SURVEY
UNDER

Application No. 46327. Permit No. 34209.
IN NAME OF

FRIEDRICH W. HEINE

Surveyed Nov. 13, 1970, by R. MUCKEN