


T.19S. R.11&12W. W.M.

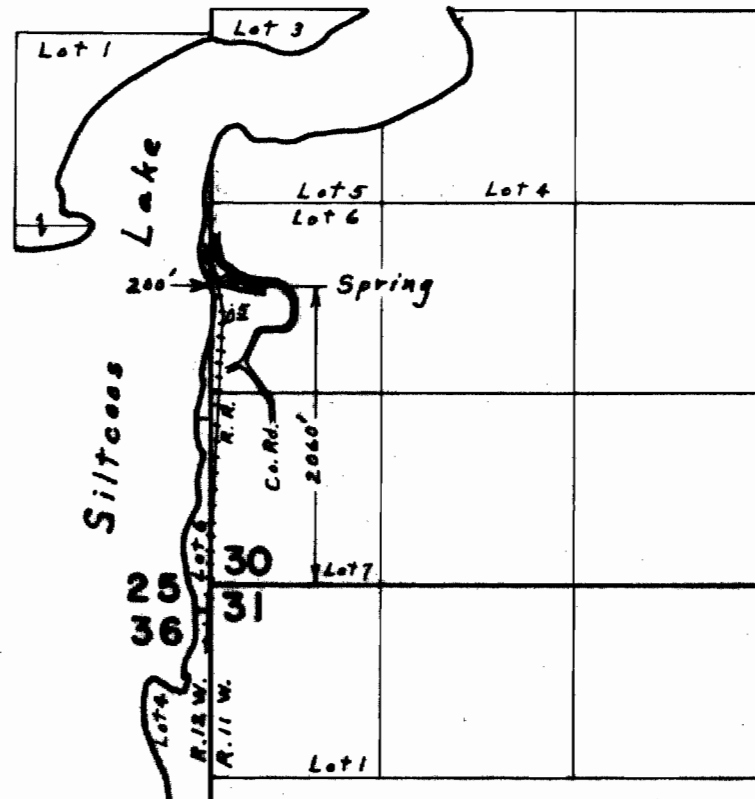

FINAL PROOF SURVEY
UNDER

Application No. 47720 Permit No. 35805
IN NAME OF

GERTRUDE M. CHRISTENSEN

Surveyed July 9, 1974, by L. E. Gould