


T.17S.R.IW.W.M.

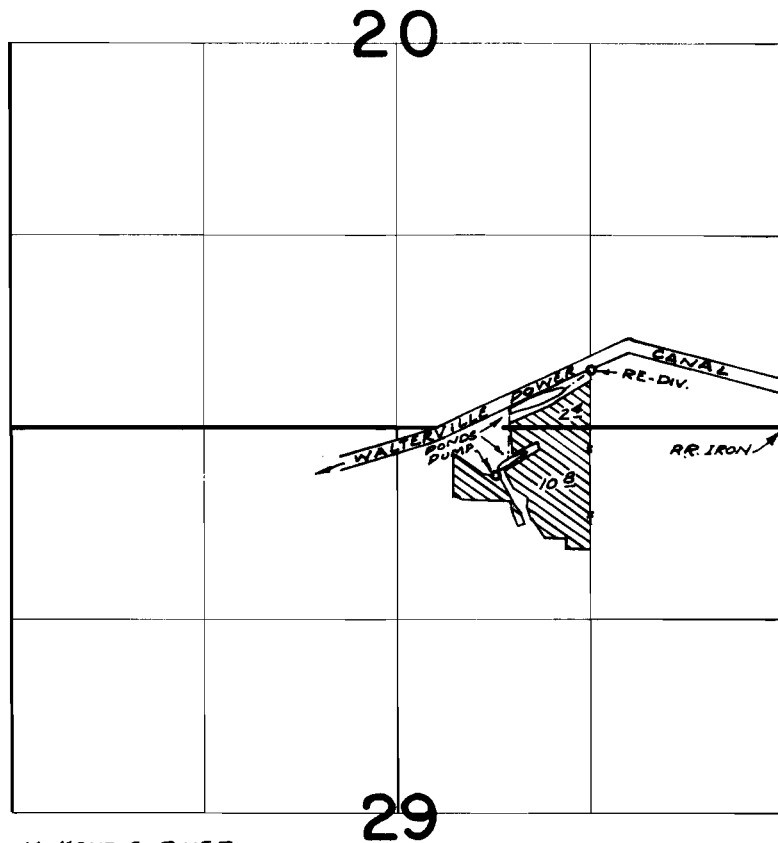

MCKENZIE RIVER
DIV. PT. LOC: LOT 1 (NE $\frac{1}{4}$ SE $\frac{1}{4}$) SEC. 23

FINAL PROOF SURVEY UNDER

Application No. ~~49264~~ Permit No. ~~35832~~
IN NAME OF

~~J. D. E/OR~~ MARTHA JOAN JACKSON

Surveyed ~~JUNE 26, 1973~~, by ~~T. J. PAUL~~