


T.19 S. R.12 W. W.M.

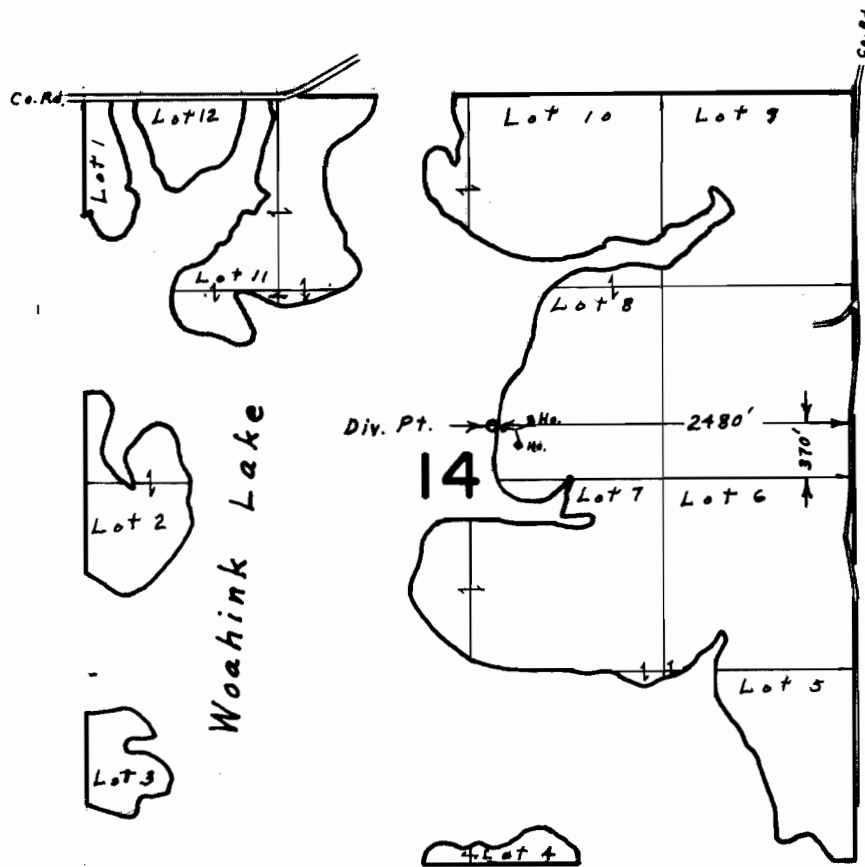

FINAL PROOF SURVEY
UNDER

Application No. 48447 Permit No. 36366
IN NAME OF
ELMER R. & MERYLE E. McBURNEY
Surveyed July 17, 1973, by L. E. Gould