


T.6S.,R.10W.,W.M.

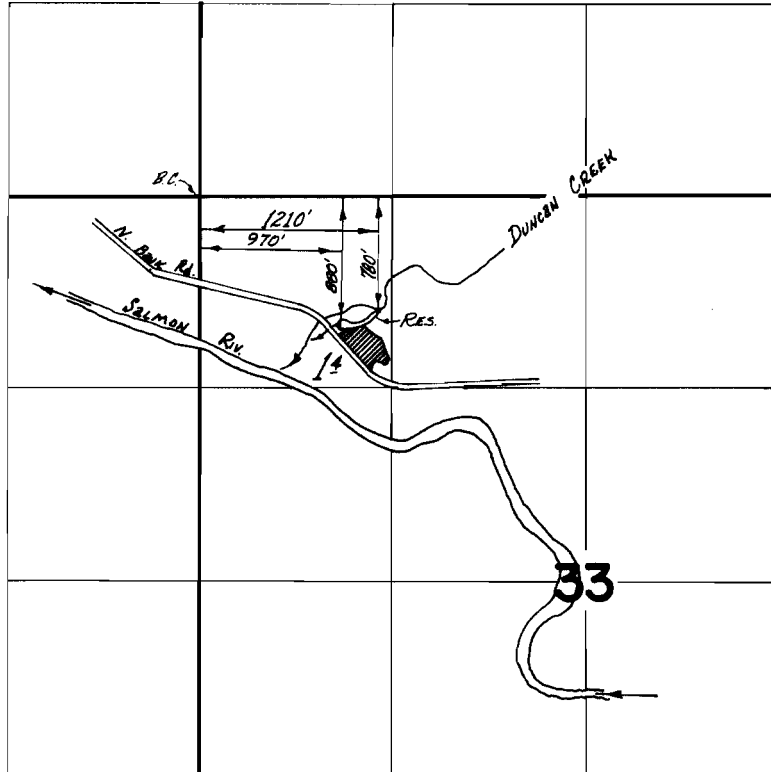

FINAL PROOF SURVEY UNDER

R-44014 R-5047
Application No. 43823 Permit No. 32762
IN NAME OF

Mrs. EVA G. McDONALD

Surveyed SEPT. 6 1973, by D. Norey