


T.6S., R.10W., W.M.

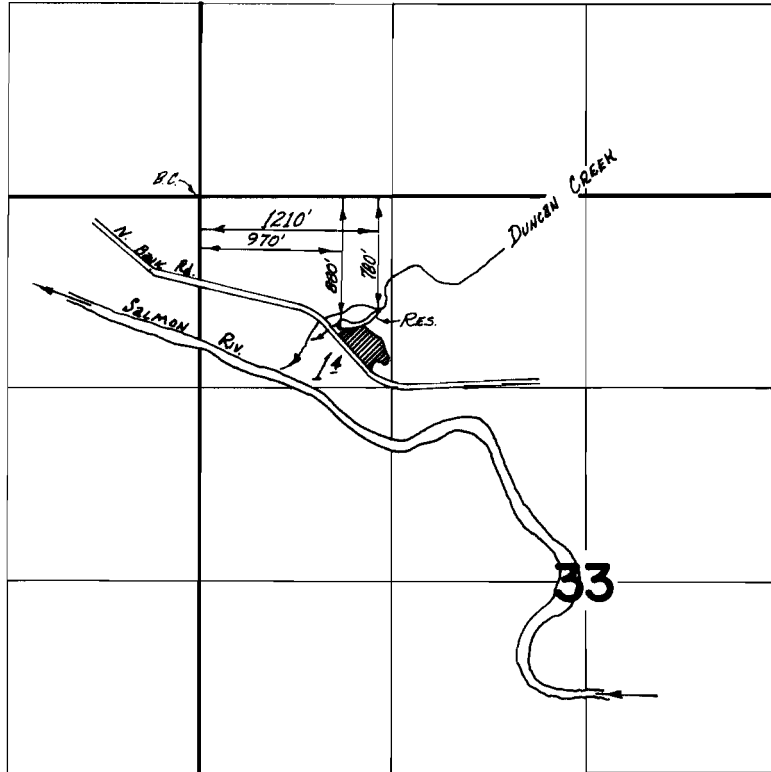

FINAL PROOF SURVEY

UNDER

R-44014 R-5047
Application No. 43823 Permit No. 32762

IN NAME OF

Mrs. EVA G. McDONALD

Surveyed SEPT. 6 1973, by D. Norey