


T.18S.,R.45E.,W.M.

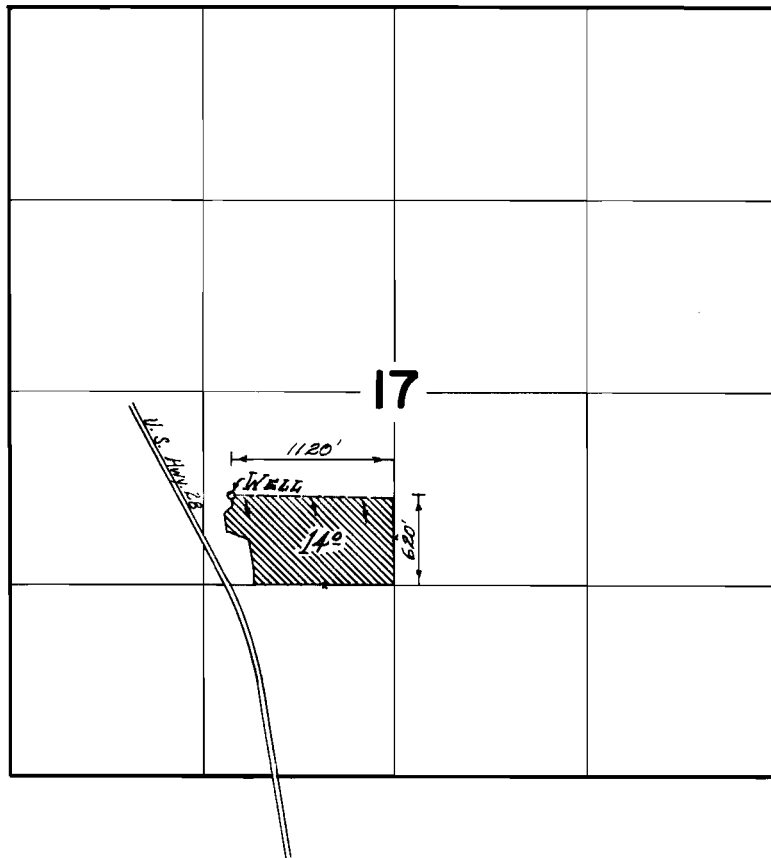

**FINAL PROOF SURVEY**  
UNDER

Application No. G-4785 Permit No. G-4507  
IN NAME OF

GEORGE JOHNSON

Surveyed MAY 25 1973, by D. NORBY