


T.18S.,R.45E.,W.M.

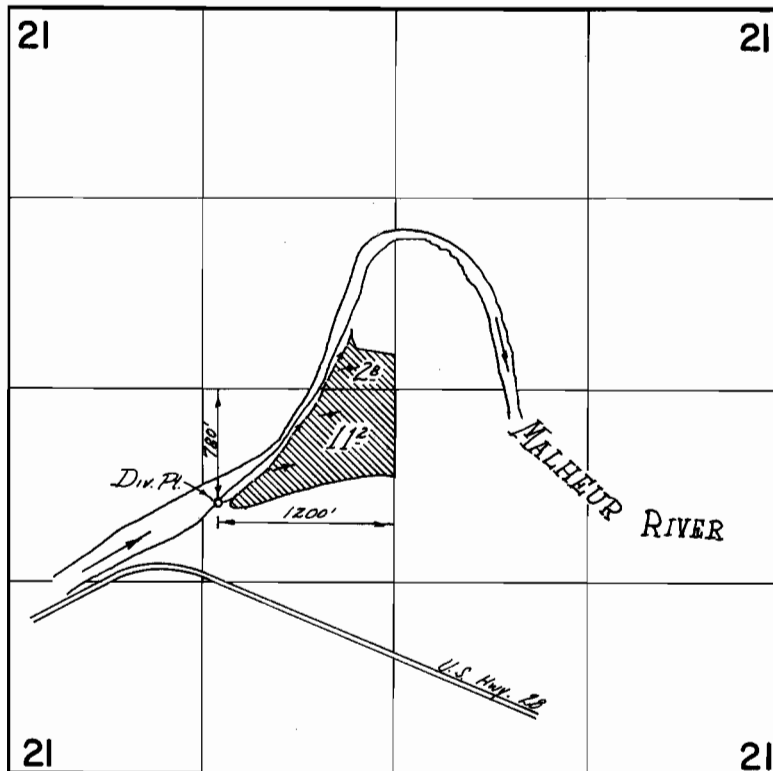

FINAL PROOF SURVEY
UNDER

Application No. 44510 Permit No. 32872
IN NAME OF

Ralph M. Metcalf & Ralph Metcalf Jr.

Surveyed May 25 1973, by D. Noray