


T.I.N. R.I.E. W.M.

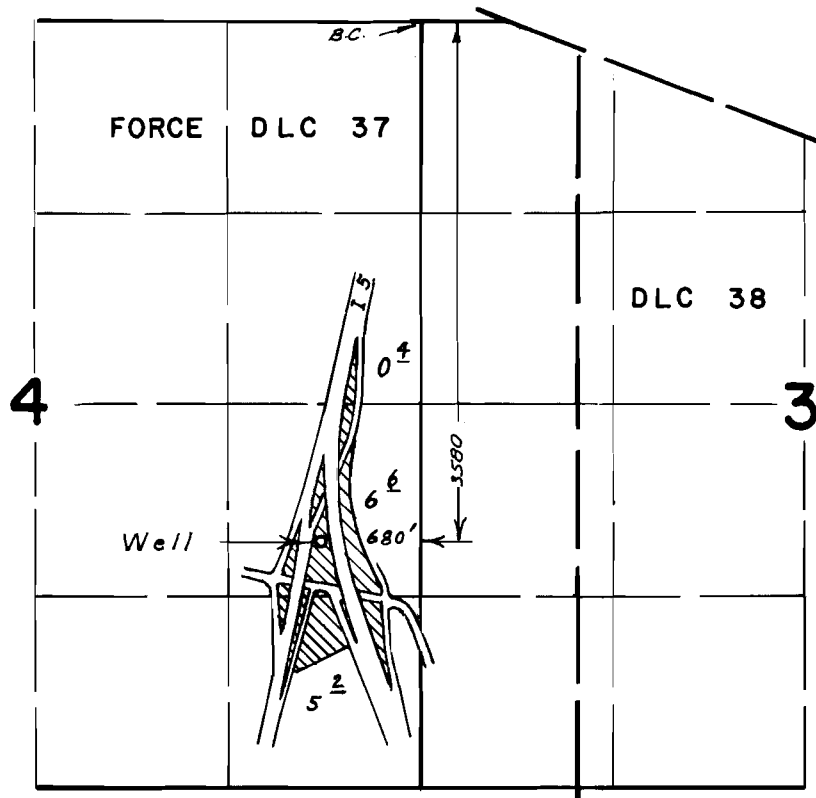

FINAL PROOF SURVEY UNDER

Application No. G-2962 Permit No. G-2755
IN NAME OF

OREGON STATE HIGHWAY COMMISSION

Surveyed May 2, 1973, by L. E. Gould