


T.8S. R.5W. W.M.

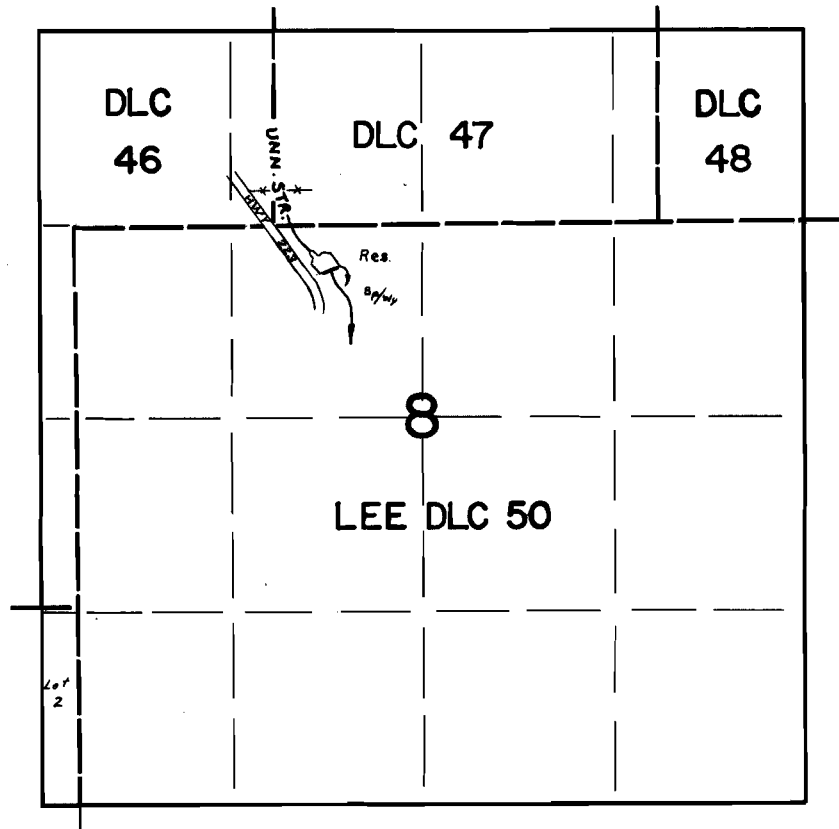

**FINAL PROOF SURVEY**  
UNDER

Application No. R-48455 Permit No. R-5883  
IN NAME OF

KINSEY BROTHERS

Surveyed JUNE 19, 1973, by R. MUCKEN

1973-S 200