


T.3N.R.10W. W.M.

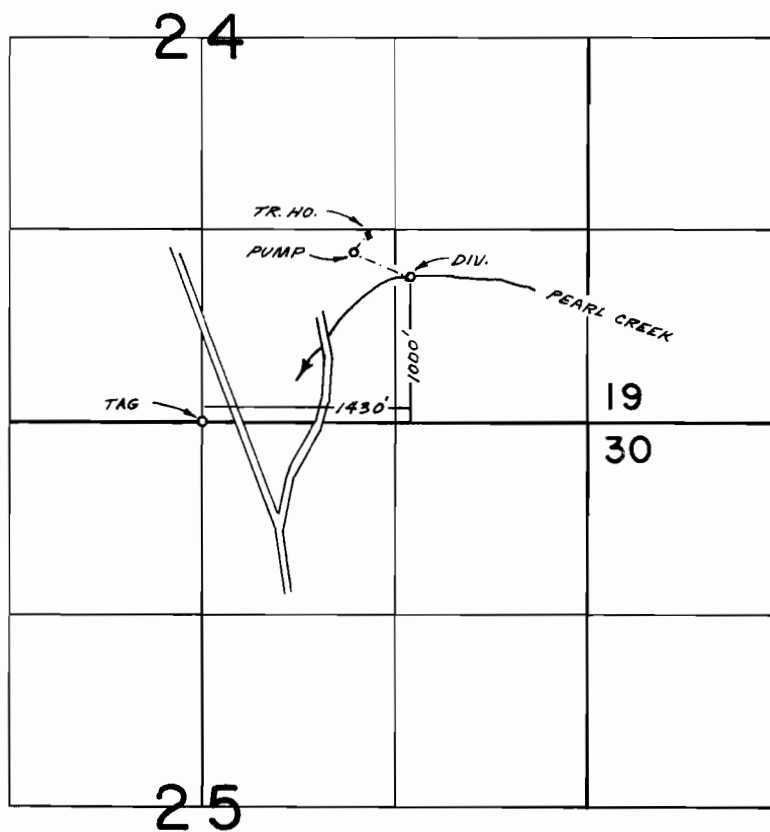

FINAL PROOF SURVEY
UNDER

Application No. 47447 Permit No. 35069
IN NAME OF

EMANUEL SCHAFER

Surveyed MAY 2 1973, by R. MUCKEN