


T.3N., R.36E., W.M.

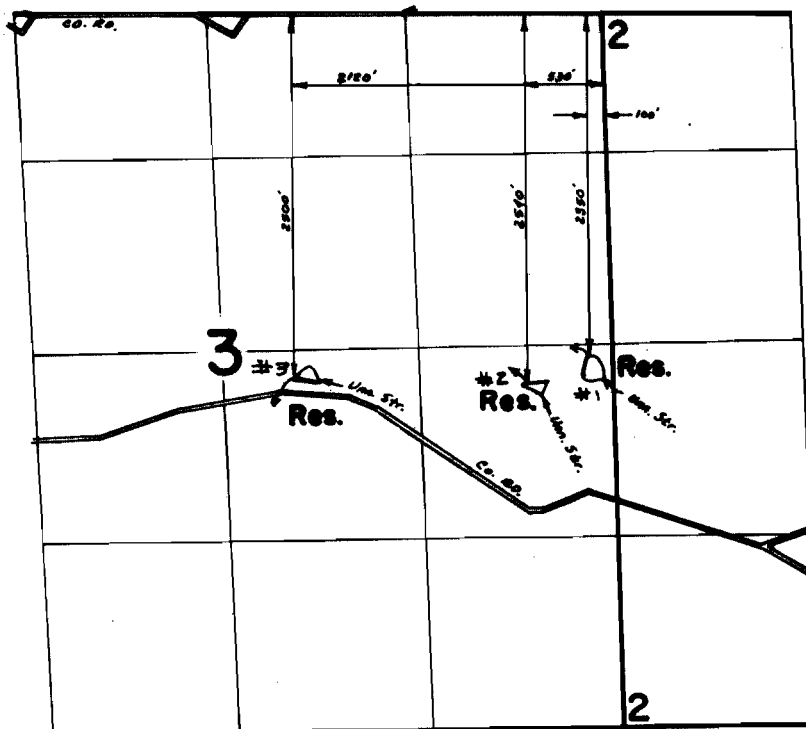

FINAL PROOF SURVEY

UNDER

Application No. R-46332 Permit No. R-5443
IN NAME OF _____

WILLIAM C. VAN ATTA

Surveyed April 18, 1973, by D. Norby