


T.4N. R.49E. W.M.

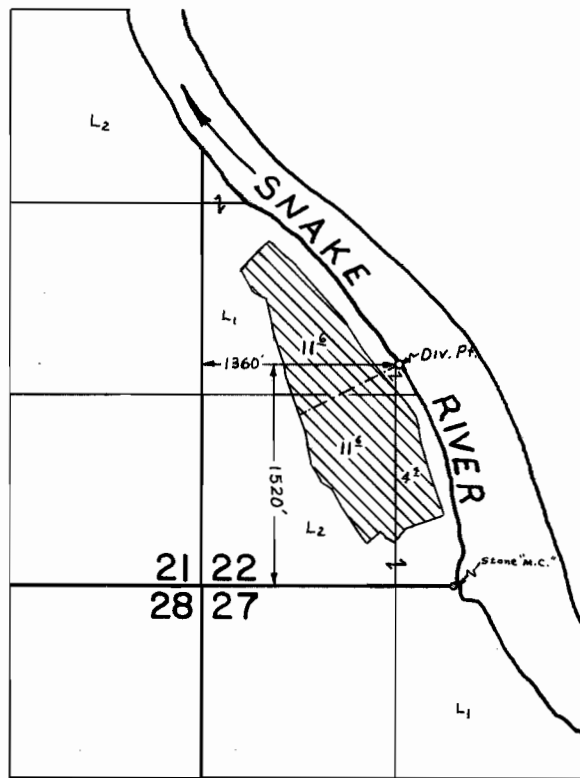

**FINAL PROOF SURVEY**  
UNDER

Application No. 41742 Permit No. 31281  
IN NAME OF

JAMES D. TIPPETT

Surveyed AUG. 7, 1973, by R. MUCKEN