


T.18&2S. R.44E. W.M.

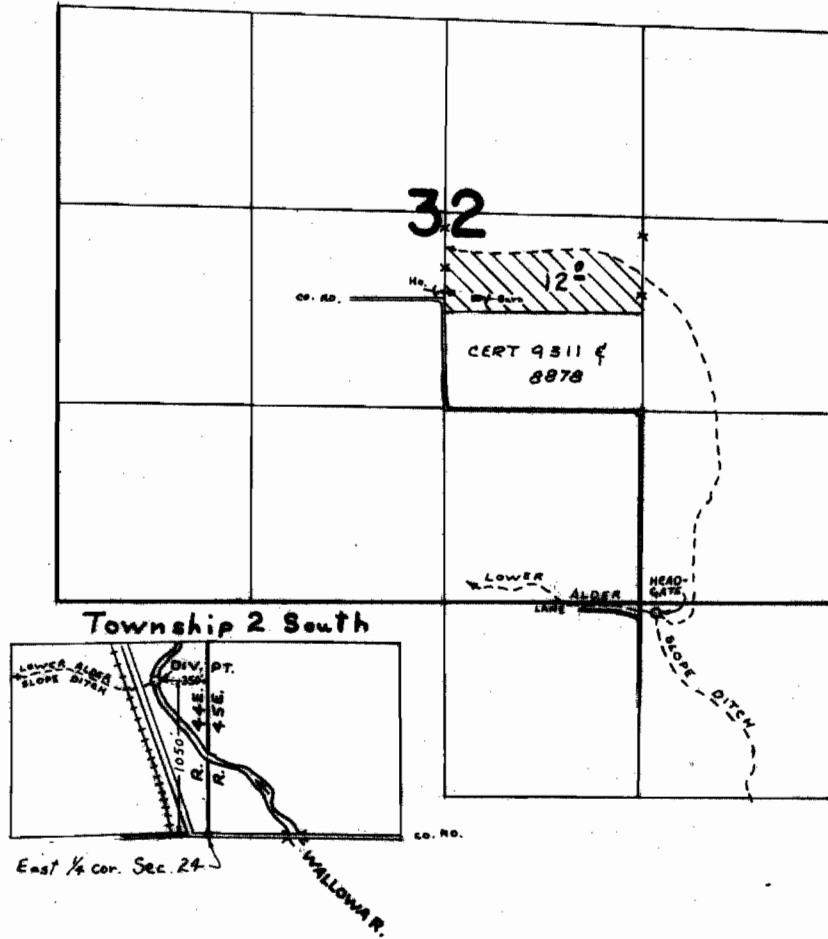

FINAL PROOF SURVEY
UNDER

Application No. 45663 Permit No. 34051
IN NAME OF

Kermit M. Wilson

Surveyed AUG. 1, 19 73, by R. MUCKEN