


T.6 S.R.I.E.W.M.

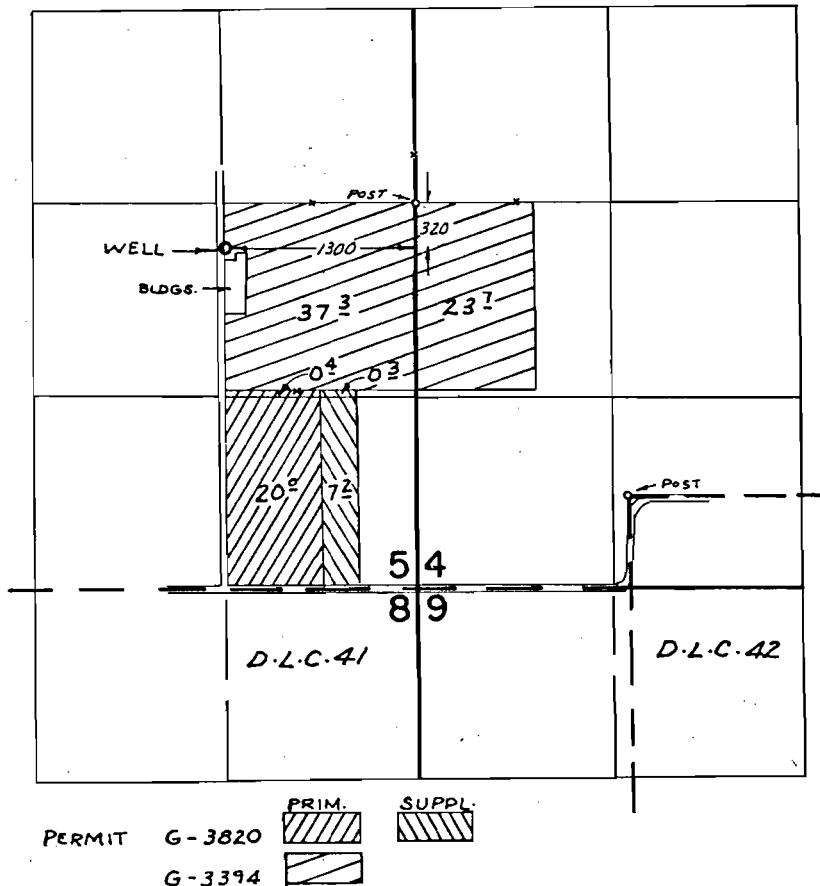

FINAL PROOF SURVEY UNDER

Application No. G-3608 Permit No. G-3394
G-4270 Permit No. G-3820
IN NAME OF

VICTOR H. SCHNEIDER

Surveyed JULY 6, 1973, by R. MUCKEN