


T.5S., R.2E., W.M.

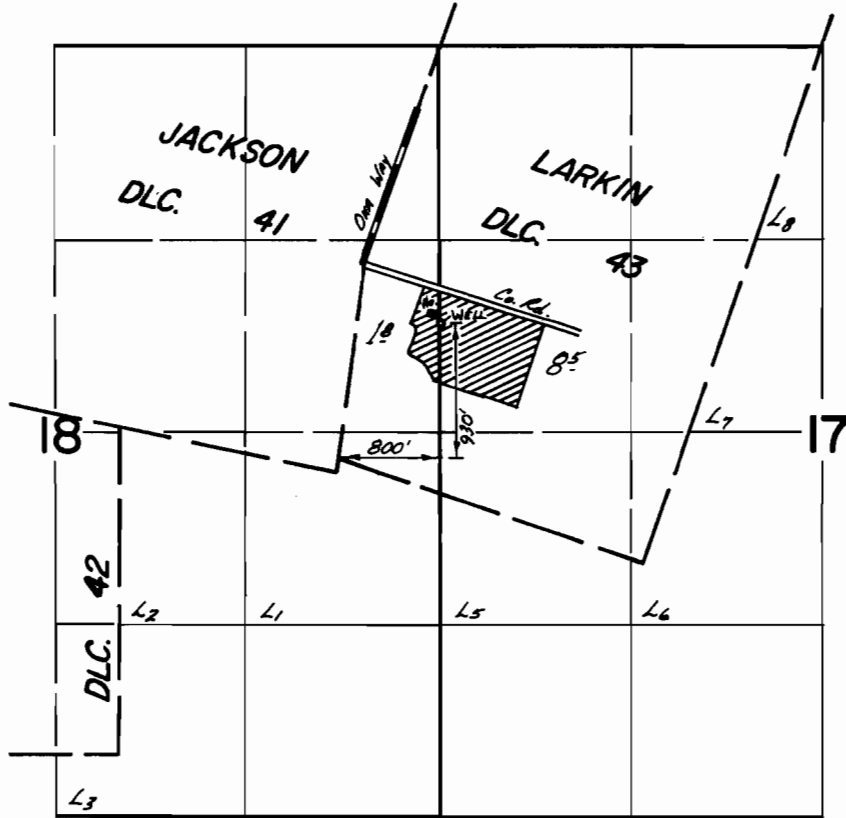

FINAL PROOF SURVEY
UNDER

Application No. G-3655 Permit No. G-3434
IN NAME OF

CHAUNCEY BUNKE

Surveyed July 26 1973, by D. NORBY