


T.4S.R.1E.W.M.

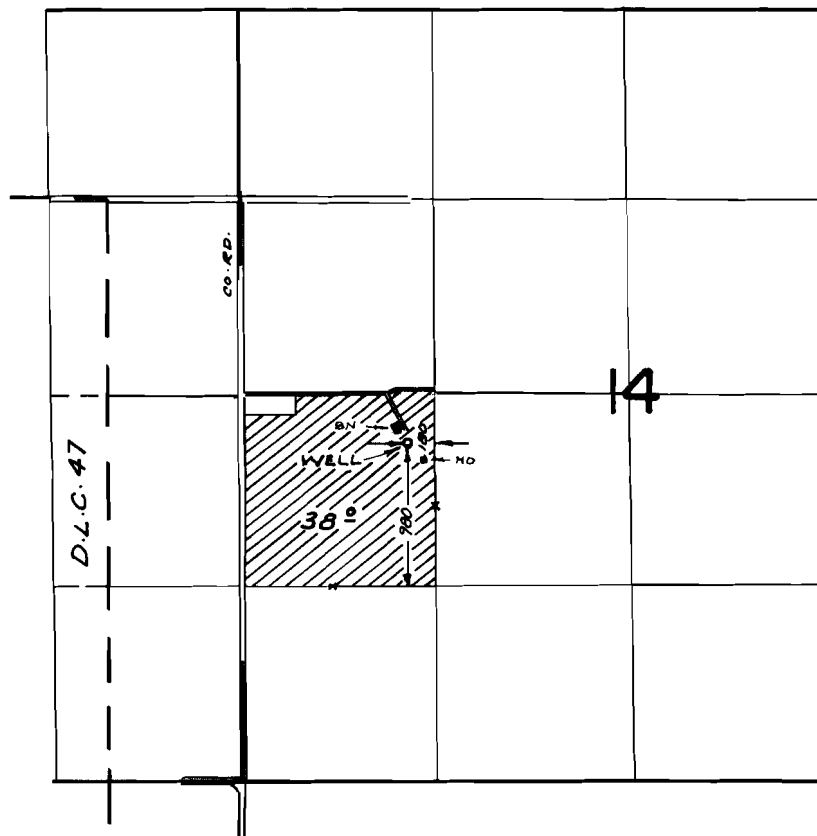

FINAL PROOF SURVEY
UNDER

Application No. G-4227 Permit No. G-3991
IN NAME OF

JOHN HARMS

Surveyed OCT. 26, 1973, by R. MUCKEN