


T.6S.R.I.E.W.M.

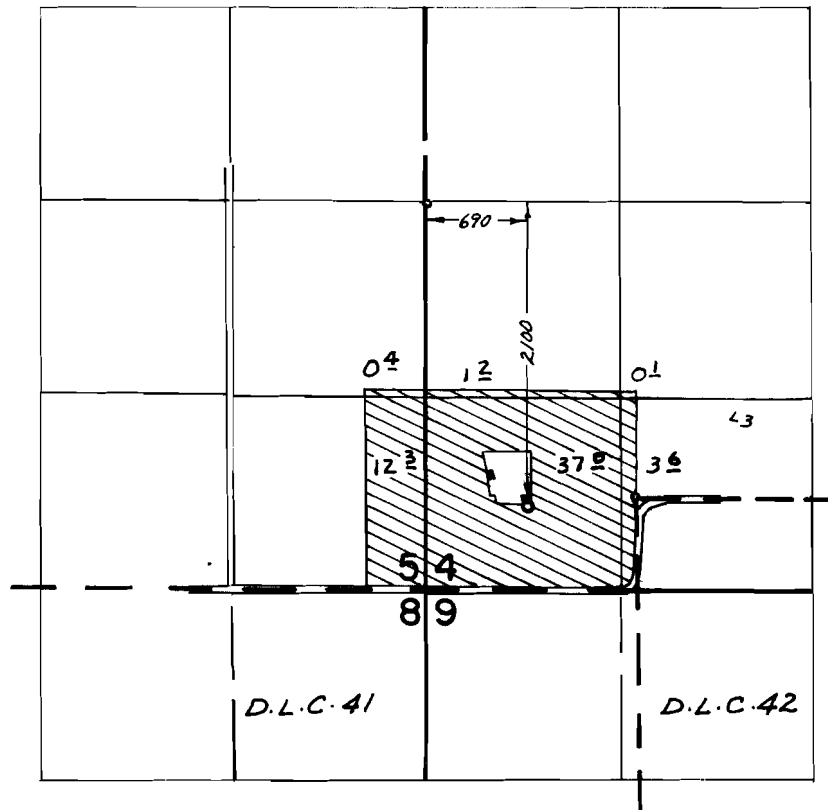

FINAL PROOF SURVEY UNDER

Application No. G-4352 Permit No. G-4107
IN NAME OF

MARTIN SCHNEIDER & VERONICA SCHNEIDER

Surveyed JULY 6., 1973. by R. MUCKEN