


T.4S.R1E.W.M.

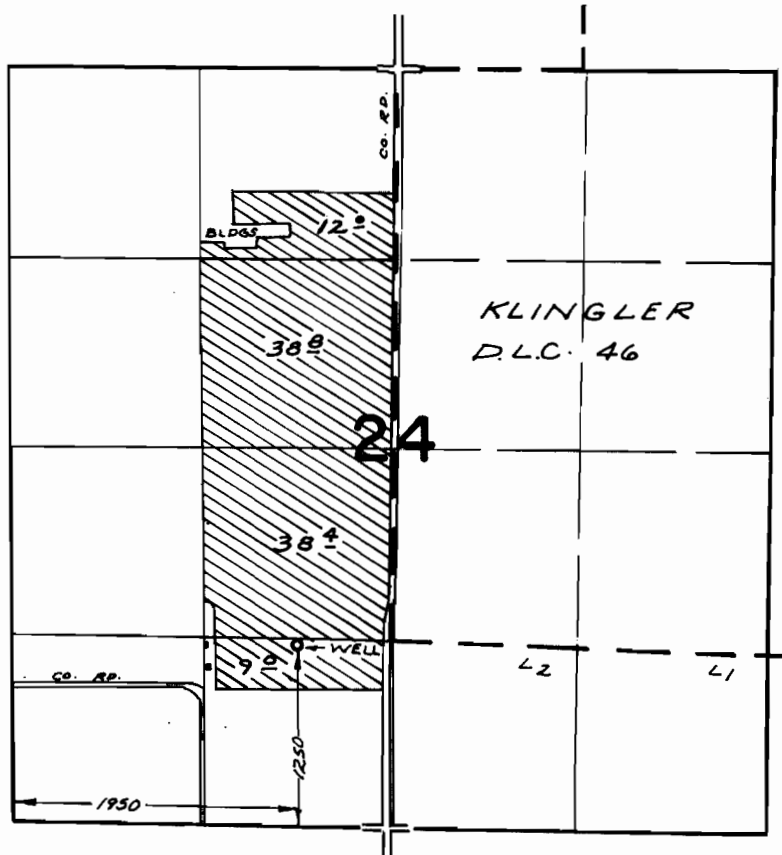

FINAL PROOF SURVEY UNDER

Application No. G-4654 Permit No. G-4378
IN NAME OF

RUFUS KRAXBERGER

Surveyed Oct. 26 1973, by R. MUCKEN