


# T.6S.R.IE.W.M.

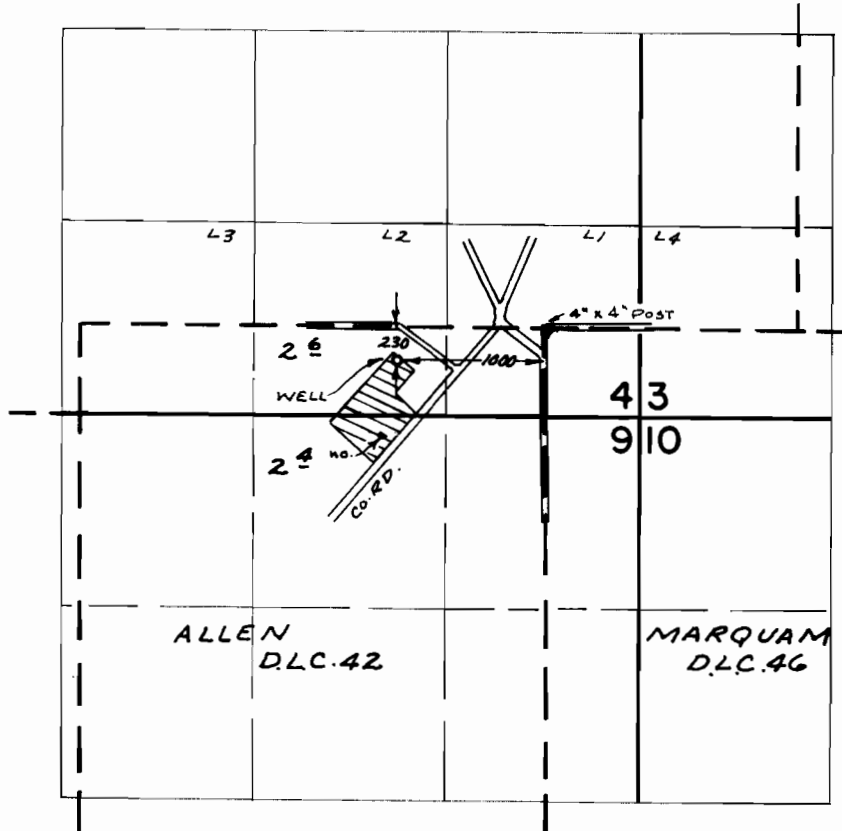

## FINAL PROOF SURVEY UNDER

Application No. G-4659 Permit No. G-4383  
IN NAME OF

KELMA KING

Surveyed JULY 2, 1973, by R. MUCKEN