


T.4S.R.4E.W.M.

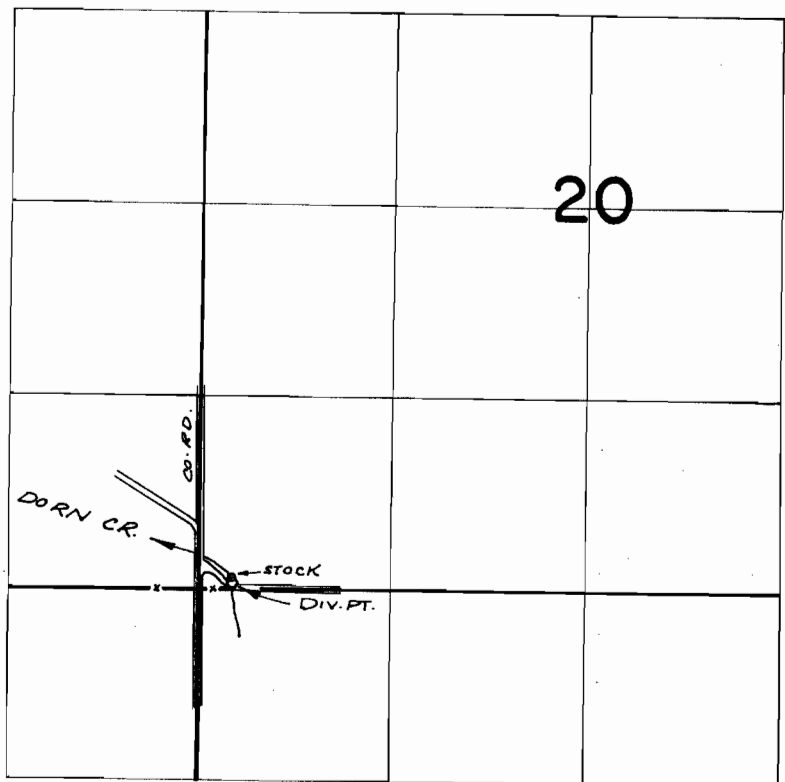

DIV. PT. LOC: 30' N. & 220' E. FROM S.W. COR. SEC. 20

FINAL PROOF SURVEY
UNDER

Application No. 42889 Permit No. 32053
IN NAME OF

GEORGE L. LEDBURY

Surveyed SEPT. 25, 1973, by R. MUCKEN