


T.2S. R.5E. W.M.

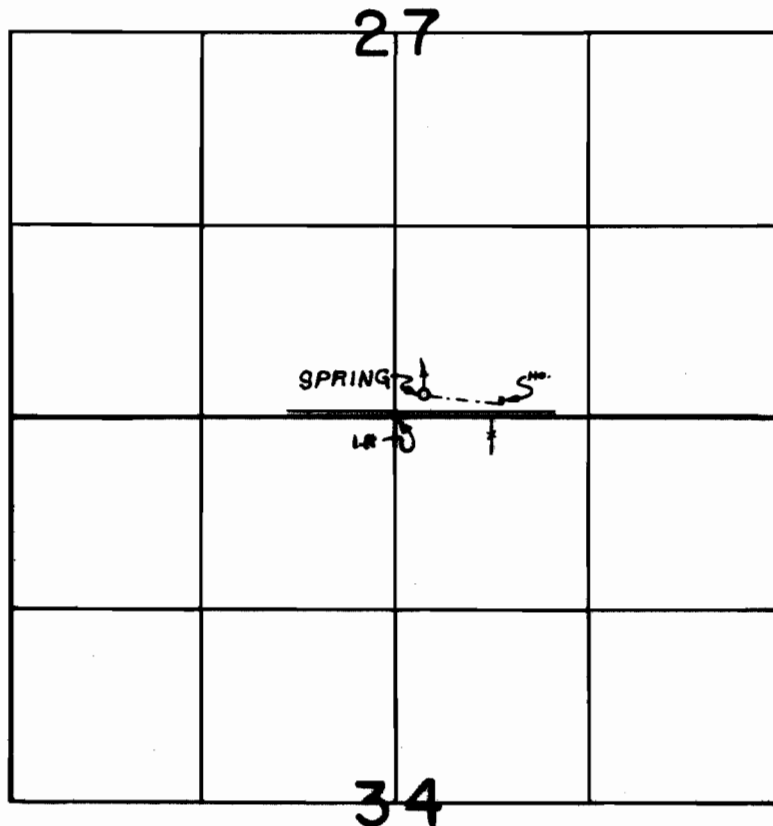

SPRING LOC: 150' N X 200' E. FROM S. 1/4 COR. SEC. 27

FINAL PROOF SURVEY
UNDER

Application No. 47255 Permit No. 35395
IN NAME OF
CITY OF SANDY

Surveyed Sept. 12 1973, by R. MUCKEN