


T.3S. R.7E. W.M.

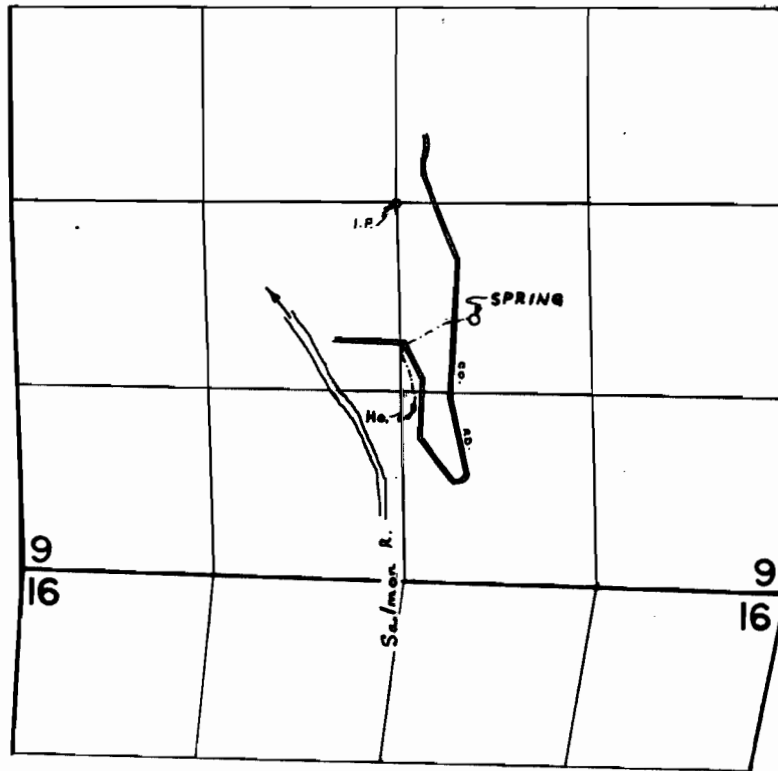

SPRING LOC: 800' S. $\frac{1}{2}$ 540' E. FROM CEN. SEC. 9

FINAL PROOF SURVEY
UNDER

Application No. 48938 Permit No. 36646
IN NAME OF

MRS. EMILY HEYDEN

Surveyed SEPT. 10, 1973, by R. MUCKEN