


T.3S. R.4E. W.M.

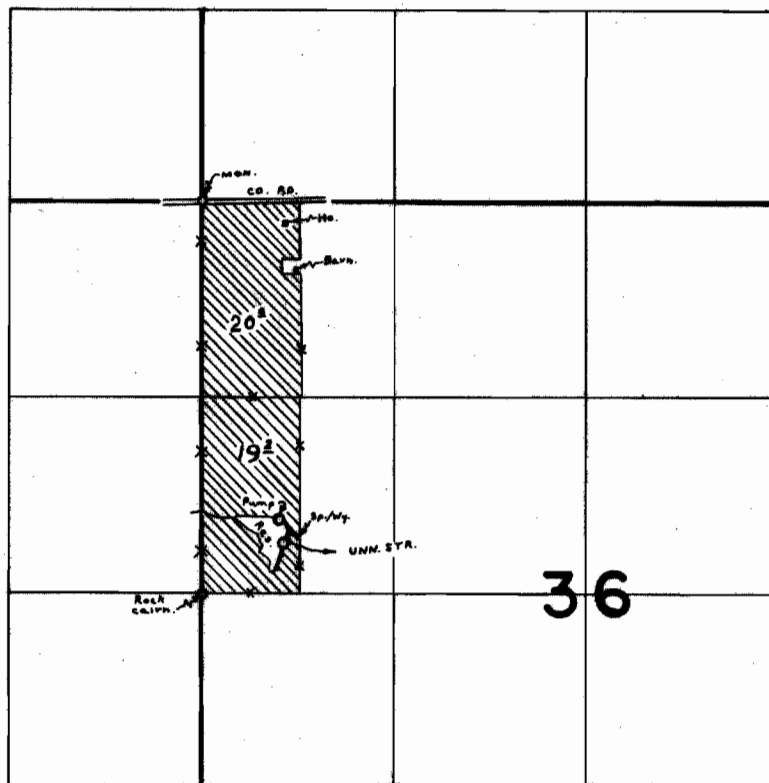

Div. Pts. Loc: Pump - 490' N. & 520' E., Dam - 340' N. & 560' E. both From W. 1/4 cor. Sec. 36.

FINAL PROOF SURVEY
UNDER

44037 32912
R-45705 R-5354
Application No. 45706 Permit No. 33842

IN NAME OF

MAURICE MONTGOMERY

Surveyed Oct. 3, 1973, by R. MUCKEN