

CERTIFICATE OF SURVEYOR

I, Michael Spears

of Canyon City Oregon

this map was made from notes taken during an actual survey made by me

on Feb 7th 1910

presents the works described on this map

from which it is proposed to take the water

Application No. 660,
Permit No. 299.

Scale One inch = 10 chains

Michael Spears

do hereby certify



1910 and that it correctly

together with the location of the spring

County Grant Co
Surveyor Oregon

Sec 33

Twp 12 S R 26 E W. 1/4

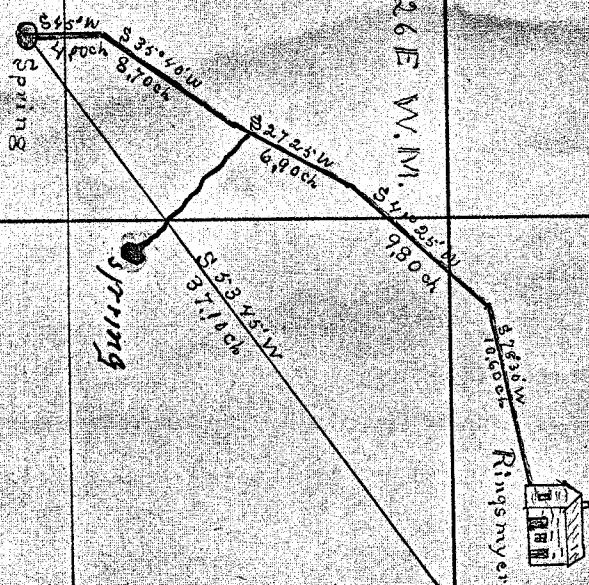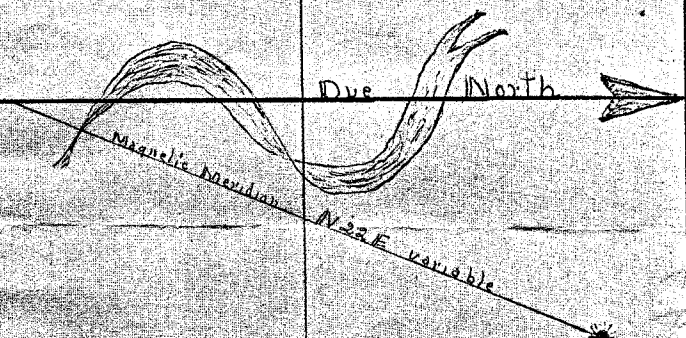

Plat of Ringsmyer Pipe Line

Henry Ringsmyer Proprietor
Dayville Grant Co Oregon