


T.5S., R.2E., W.M.

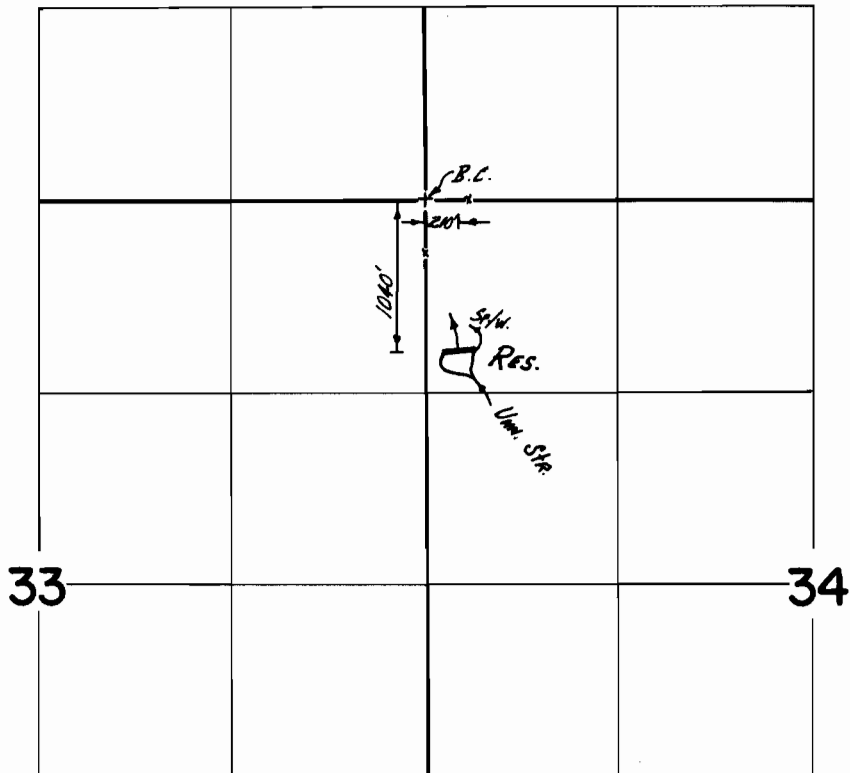

FINAL PROOF SURVEY
UNDER

Application No. R-45625 Permit No. R-5394
IN NAME OF

H. B. STEVENS

Surveyed July 26 19 73, by D. Norby