


T.6&7S.R.2E.W.M

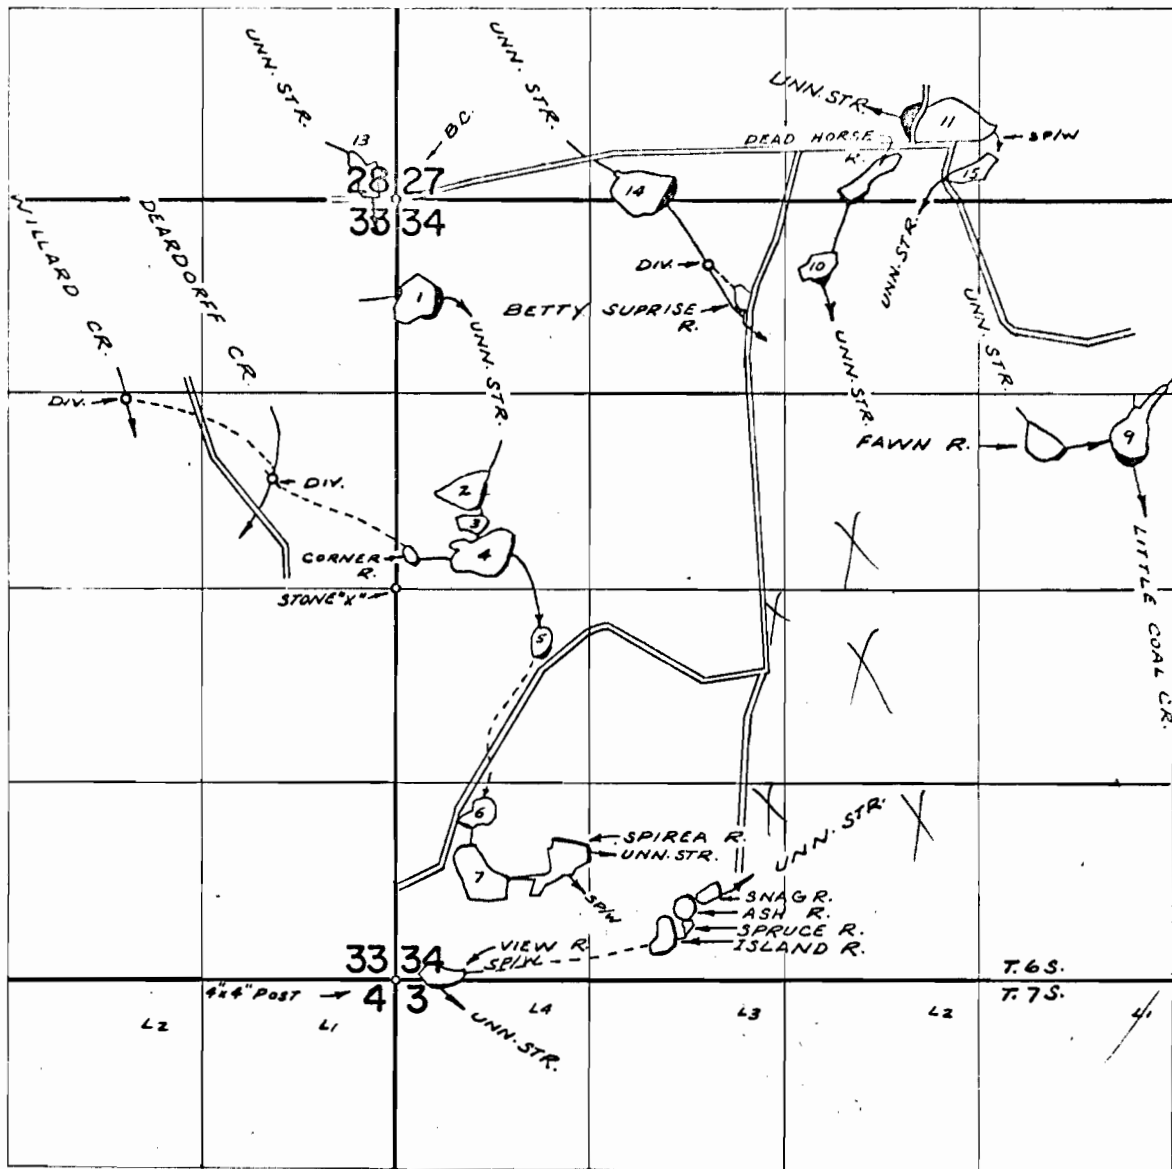

FINAL PROOF SURVEY

FOR

WILLARD G. DEARDORFF

JUNE 15,

Surveyed 12.20.21. 1973, by R. MUCKEN

APPLICATION NO.	PERMIT NO.
R-44909	R-5621
44910	35081
R-44911	R-5313
44912	33642
R-44913	R-5622
44914	35082
R-44915	R-5314
44916	33643
R-44917	R-5623
44918	35083
R-46572	R-5551
46573	34784
R-49161	R-5983
49281	36934
R-47086	R-5646
47087	35232