


T.5S.,R.3E.,W.M.

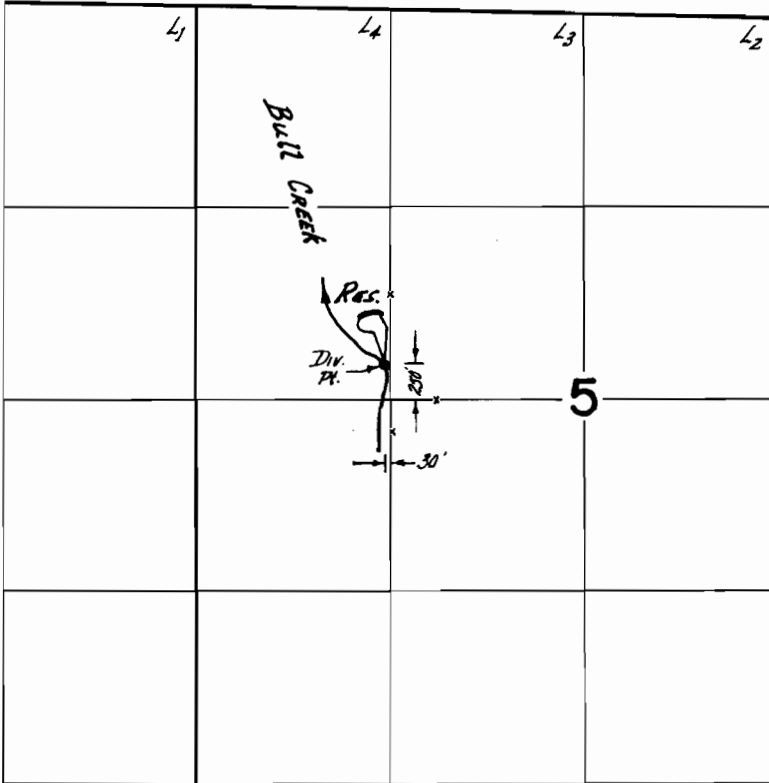

FINAL PROOF SURVEY
UNDER

R-46644 R-5573
Application No. 46645 Permit No. 34853
IN NAME OF

ROARING BULL CREEK SUBDIVISION (DEARDORFF)

Surveyed July 24 19 73, by D. NORBY