


T.5S., R.3E., W.M.

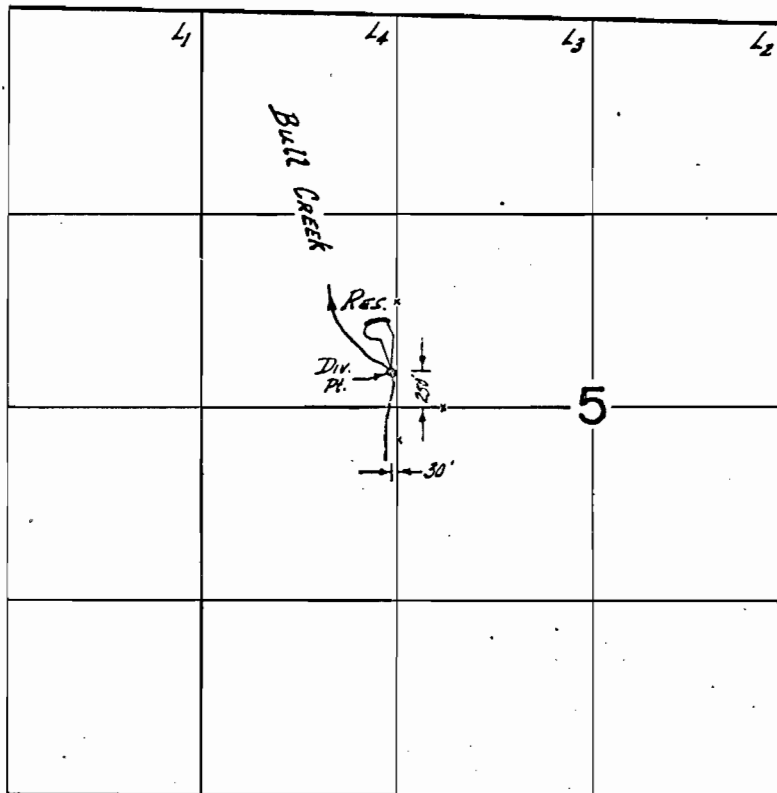

FINAL PROOF SURVEY
UNDER

R-46644 R-5573
Application No. 46645 Permit No. 34853
IN NAME OF

ROARING BULL CREEK SUBDIVISION (DEARDORFF)

Surveyed July 24 1973, by D. NORBY