


T.687S.R.2E.W.M

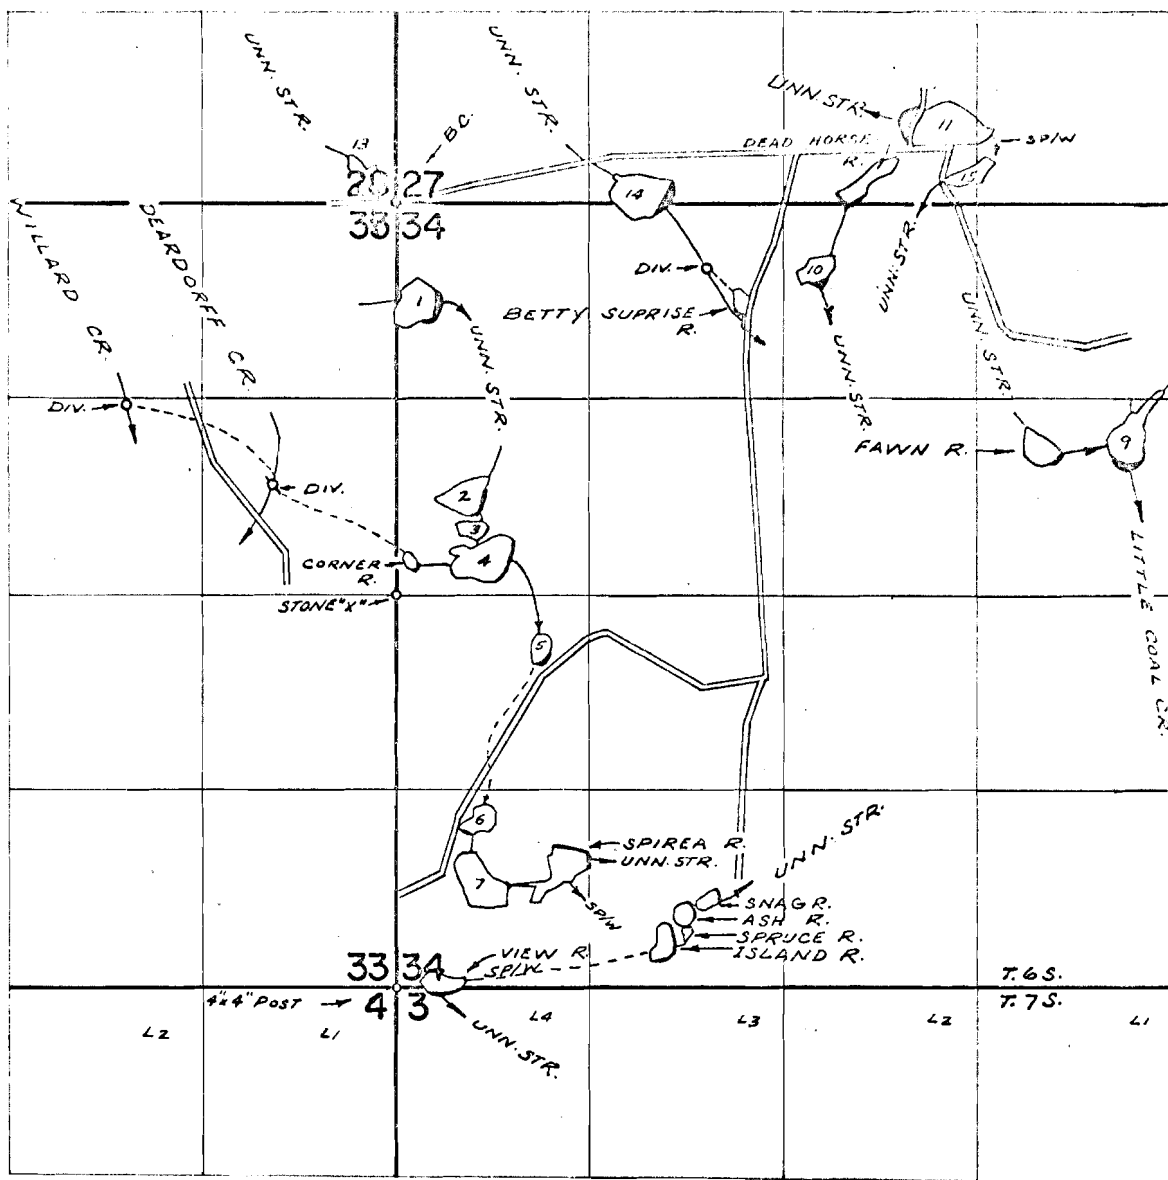

DIV. PTS. LOC.

- RES. 1 - 680' S 92.90° E FROM NW COR. SEC. 34
- RES. 2 - 570' N 57.0° E FROM W 1/4 COR. SEC. 34
- RES. 3 - 380' N 55.0° E " " " "
- RES. 4 - 230' N 77.0° E " " " "
- RES. 5 - 470' S 93.0° E " " " "
- RES. 6 - 1030' N 52.0° E FROM S.W. COR. SEC. 34
- RES. 7 - 680' N 76.0° E " " " "
- RES. 9 - 1780' S 53.00° E FROM NW COR. SEC. 34
- RES. 10 - 550' S 28.90° E " " " "
- RES. 11 - 570' N 34.10° E " " " "
- RES. 13 - 20' N 145° W " " " "
- RES. 14 - 20' S 152.0° E " " " "
- RES. 15 - 150' N 372.0° E " " " "

FINAL PROOF SURVEY

- BETTY SURPRISE
- UNN. STR. 440' S 42.100° E " " " " (OFF CHANNEL DIV.)
- FAWN - 1690' S 45.30° E " " " "
- CORNER - 140' N 140° E FROM C 1/4 COR. SEC. 33
- WILLARD CR. - 1270' N 184.0° W FROM W 1/4 COR. SEC. 34
- DEARDORFF CR. - 150' N 84.0° W " " " "
- SPIREA - 870' N 13.0° E FROM SW COR. SEC. 34
- VIEW - 50' S 32.0° E " " " "
- DEAD HORSE - 22.10° S 30.50° E FROM N.W. COR. SEC. 34
- SNAG - 580' N 22.10° E FROM S.W. COR. SEC. 34
- ASH - 560' N 20.10° E " " " "
- SPRUCE - 10' N 198.0° E " " " "
- ISLAND - 280' N 187.0° E " " " "

FOR

WILLARD G. DEARDORFF

JUNE 15,

Surveyed 1920-21, 1973, by R. MUCKEN

APPLICATION NO.

PERMIT NO.

R-44909	R-5621
44910	35081
R-44911	R-5313
44912	35642
R-44913	R-5622
44914	35082
R-44915	R-5314
44916	33643
R-44917	R-5623
44918	35083
R-46572	R-5551
46573	34784
R-49161	R-5983
49281	36934
R-47086	R-5646
47087	35232