


T.5S., R.3E., W.M.

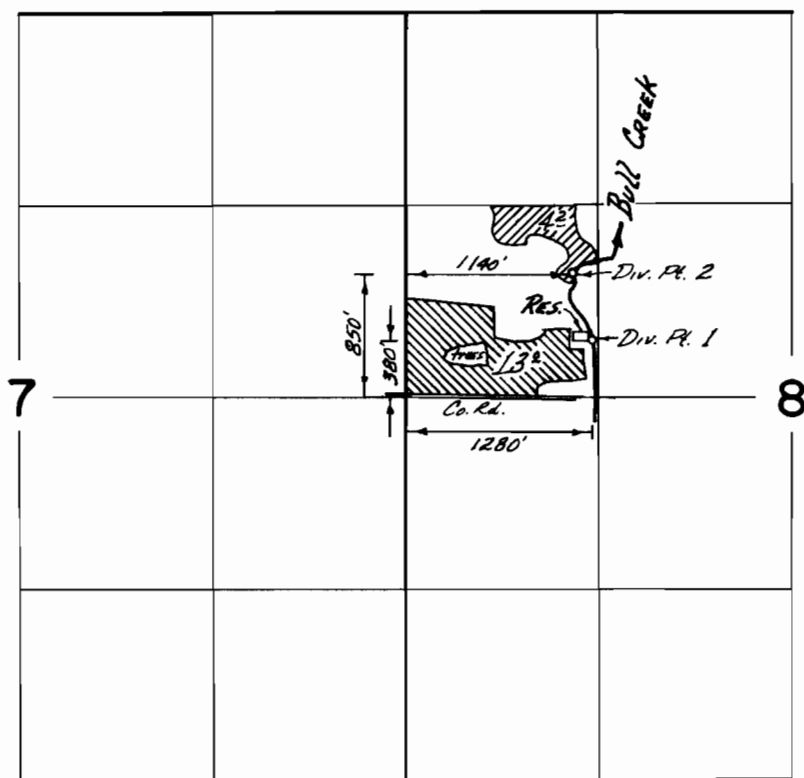

▨ Bull Creek & Reservoir
▨ Bull Creek only

FINAL PROOF SURVEY
UNDER

R-47370 R-5702
Application No. 47371 Permit No. 35479
IN NAME OF
FRED E. WALLACE

Surveyed July 25 1973, by D. NORBY