T.5S., R.3E., W.M.

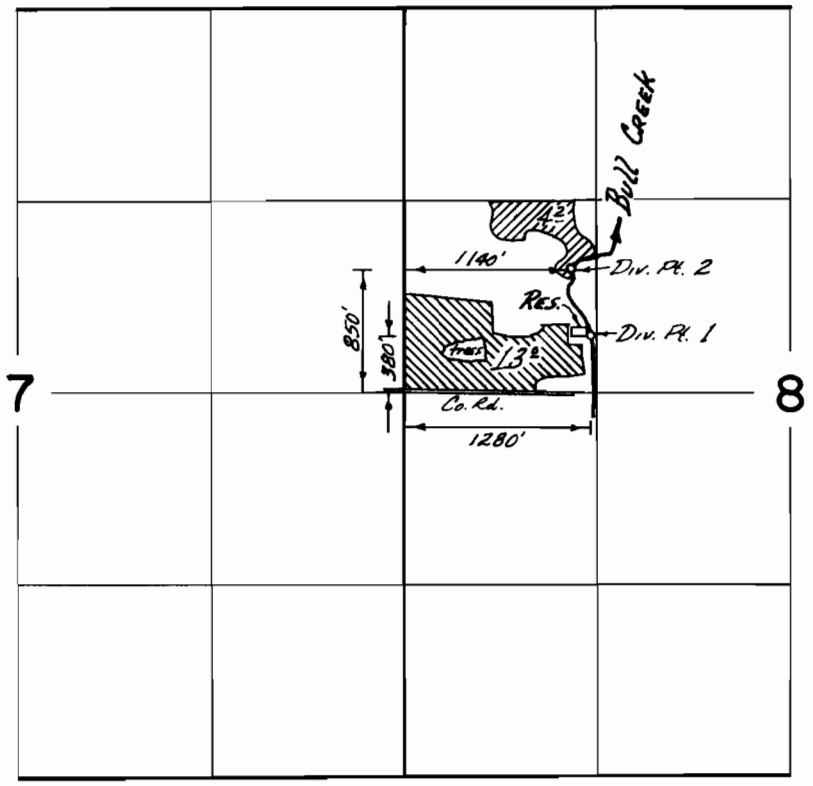

Bull Creek & Reservoir
Bull Creek only

FINAL PROOF SURVEY
UNDER

R-47370 R-5702
Application No. 47371 Permit No. 35479
IN NAME OF

FRED E. WALLACE

Surveyed July 25 19 73, by D. NORBY

DFK-10-93 & 1973-B