


T.6S., R.2E., W.M.

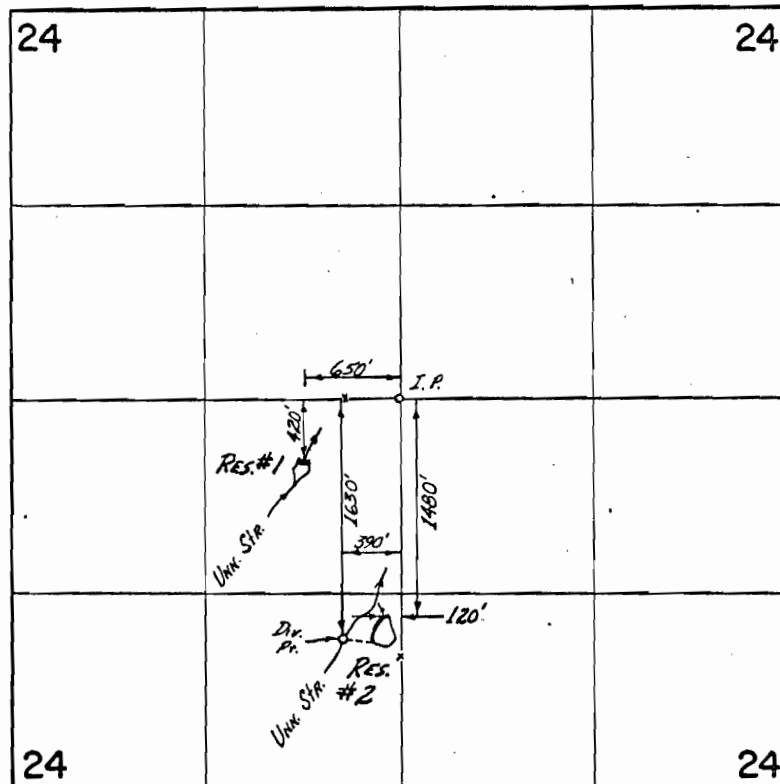

FINAL PROOF SURVEY
UNDER

R-48383 R-5877
Application No. 48389 Permit No. 36326
IN NAME OF

NORMAND SCHOENBORN

Surveyed July 27 1973, by D. Narey