


T.6S., R.2E., W.M.

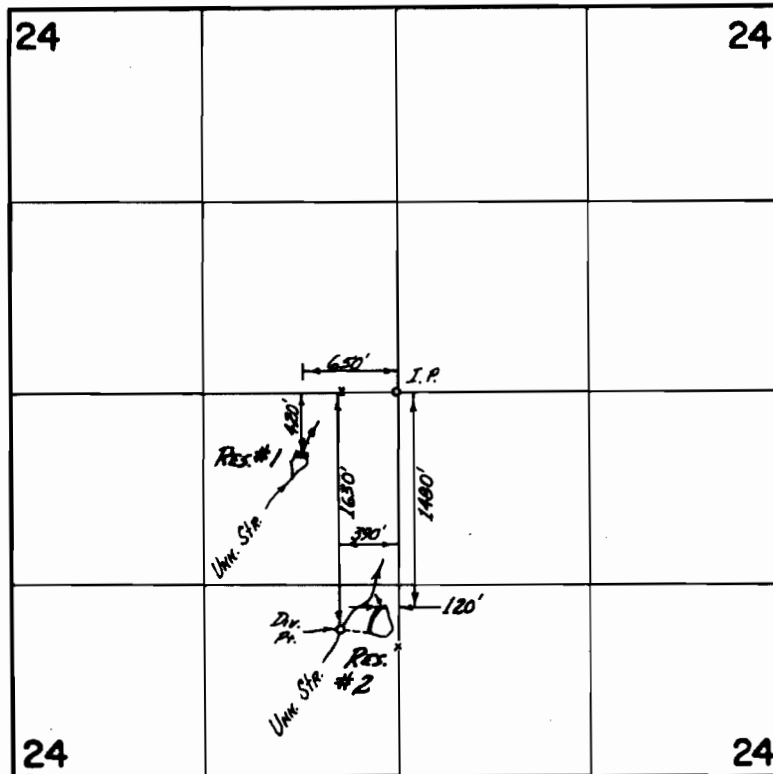

**FINAL PROOF SURVEY**  
UNDER

R-48388 R-5877  
Application No. 48389 Permit No. 36326  
IN NAME OF

NORMAND SCHOENBORN

Surveyed July 27, 1973, by D. Narey