


T.687S.R.2E.W.M

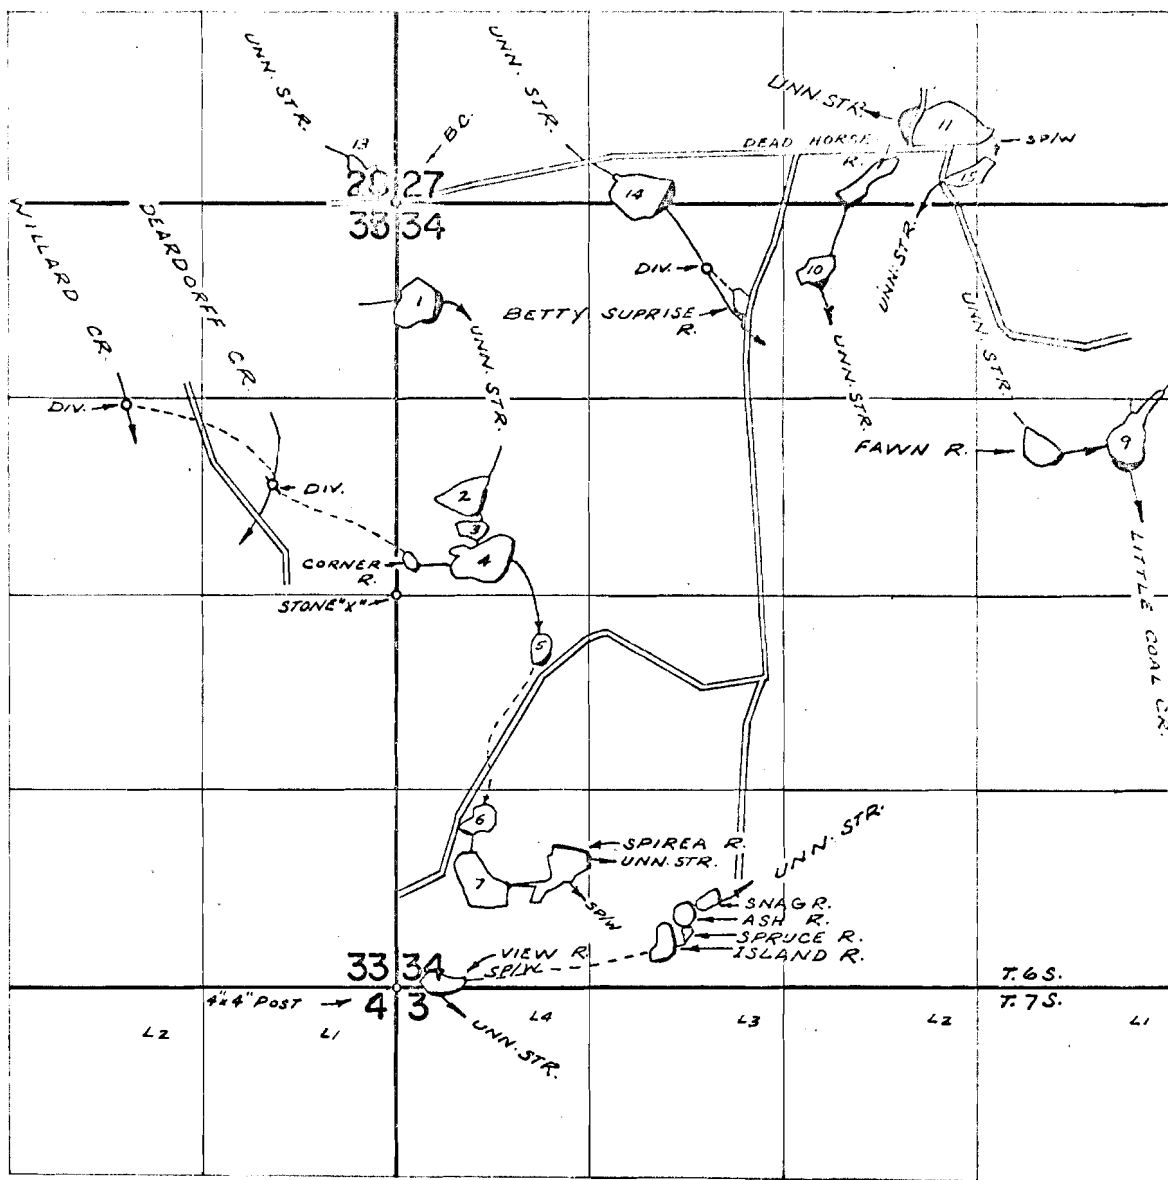

DIV. PTS. LOC.

RES. 1 - 680' S 92°30' E FROM NW COR. SEC. 34
 RES. 2 - 570' N 57°0' E FROM W 1/4 COR. SEC. 34
 RES. 3 - 380' N 55°0' E " " " "
 RES. 4 - 230' N 77°0' E " " " "
 RES. 5 - 470' S 93°0' E " " " "
 RES. 6 - 1030' N 52°0' E FROM S.W. COR. SEC. 34
 RES. 7 - 680' N 76°0' E " " " "
 RES. 9 - 1780' S 53°00' E FROM NW COR. SEC. 34
 RES. 10 - 550' S 28°0' E " " " "
 RES. 11 - 570' N 34°0' E " " " "
 RES. 13 - 20' N 145° W " " " "
 RES. 14 - 20' S 152°0' E " " " "
 RES. 15 - 150' N 372°0' E " " " "
 BETTY SURPRISE
 UNN. STR. 440' S 42°00' E " " " " (OFF CHANNEL DIV.)
 FAWN - 1680' S 45°30' E " " " "
 CORNER - 140' N 140° E FROM C 1/4 COR. SEC. 33
 WILLARD CR. - 1270' N 184° W FROM W 1/4 COR. SEC. 34
 DEARDORFF CR. - 150' N 84° W " " " "
 SPIREA - 870' N 130° E FROM SW COR. SEC. 34
 VIEW - 50 S 320° E " " " "
 DEAD HORSE - 220' S 305° E FROM N.W. COR. SEC. 34
 SNAG - 580' N 22°0' E FROM S.W. COR. SEC. 34
 ASH - 560' N 20°0' E " " " "
 SPRUCE - 10' N 198° E " " " "
 ISLAND - 280' N 187° E " " " "

FINAL PROOF SURVEY

FOR

WILLARD G. DEARDORFF

JUNE 15,

Surveyed 12.20.21. 1973, by R. MUCKEN

APPLICATION NO.

PERMIT NO.

R-44909	R-5621
44910	35081
R-44911	R-5313
44912	35642
R-44913	R-5622
44914	35082
R-44915	R-5314
44916	33643
R-44917	R-5623
44918	35083
R-46572	R-5551
46573	34784
R-49161	R-5983
49281	36934
R-47086	R-5646
47087	35232