


T.26S., R.6W., W.M.

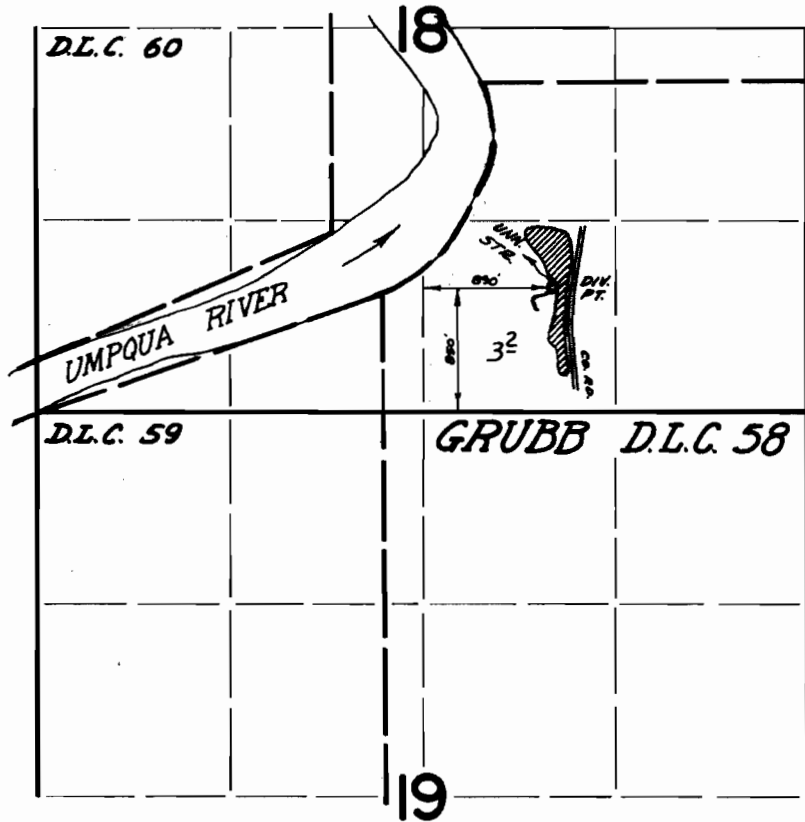

FINAL PROOF SURVEY
UNDER

Application No. 43466 Permit No. 32510
IN NAME OF

JAMES A. HAND

Surveyed Sept. 11 19 73, by D. NORBY