


T. 36S.R.4W. W.M.

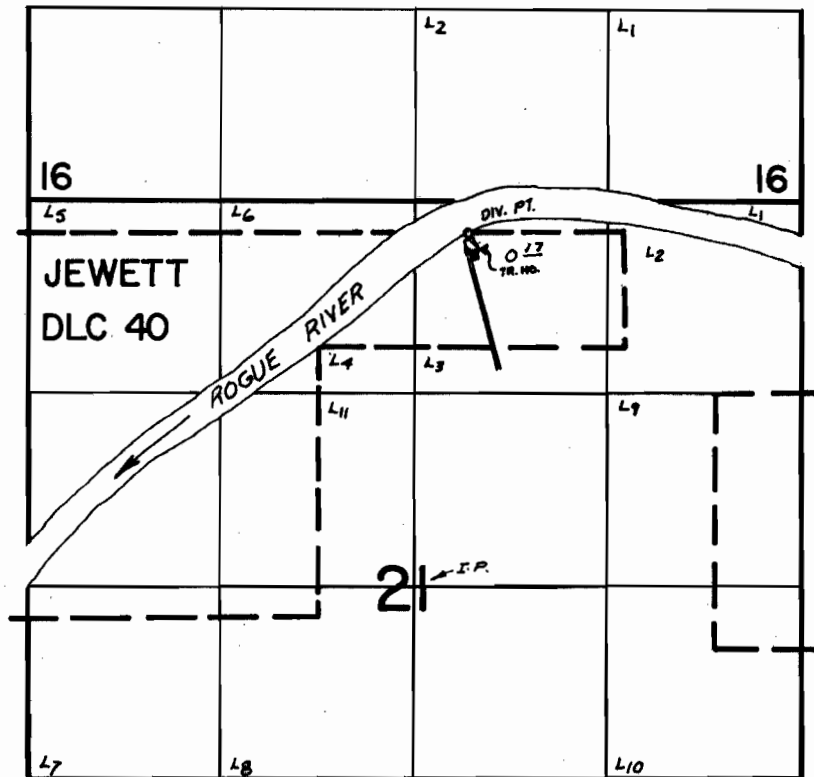

DIV. PT. 2400' N & 370' E FROM CEN SEC 21

FINAL PROOF SURVEY UNDER

Application No. 45675 Permit No. 34078
IN NAME OF

William and/or Florence Reed

Surveyed OCT 13 1973, by R.G. MUCKEN