# T. 36 S.R. 2 W.W.M.

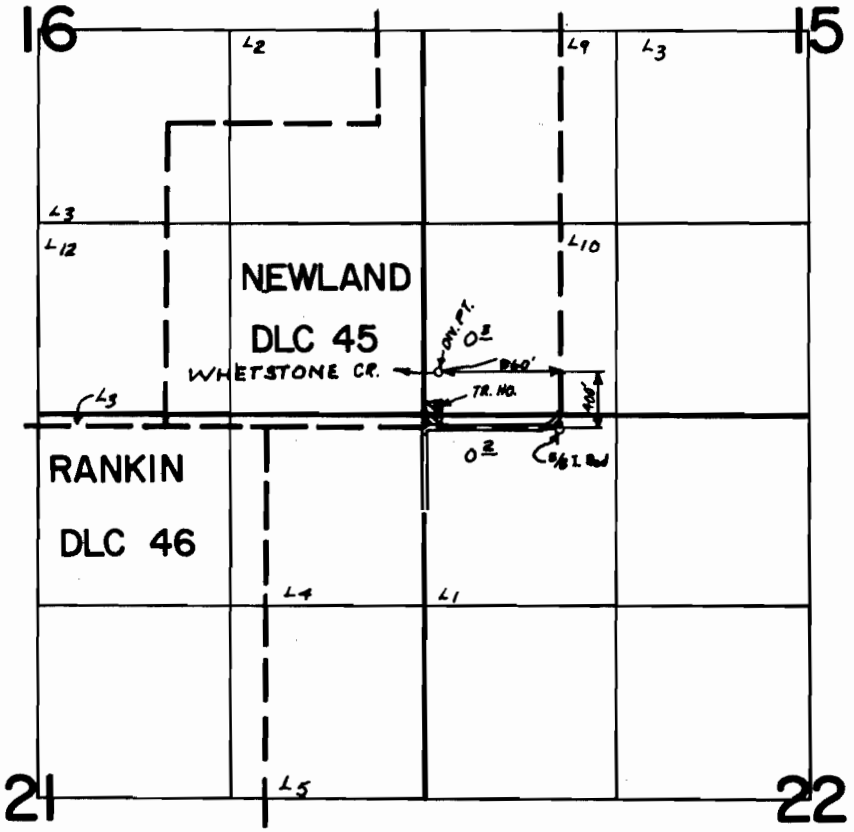


## FINAL PROOF SURVEY
UNDER

Application No. 45893 Permit No. 34268
IN NAME OF

JOAN BASSETT

Surveyed OCT 9 1973, by R.G. MUCKEN

1973 - M O.C.