


T. 37 S. R. 4 W. W.M.

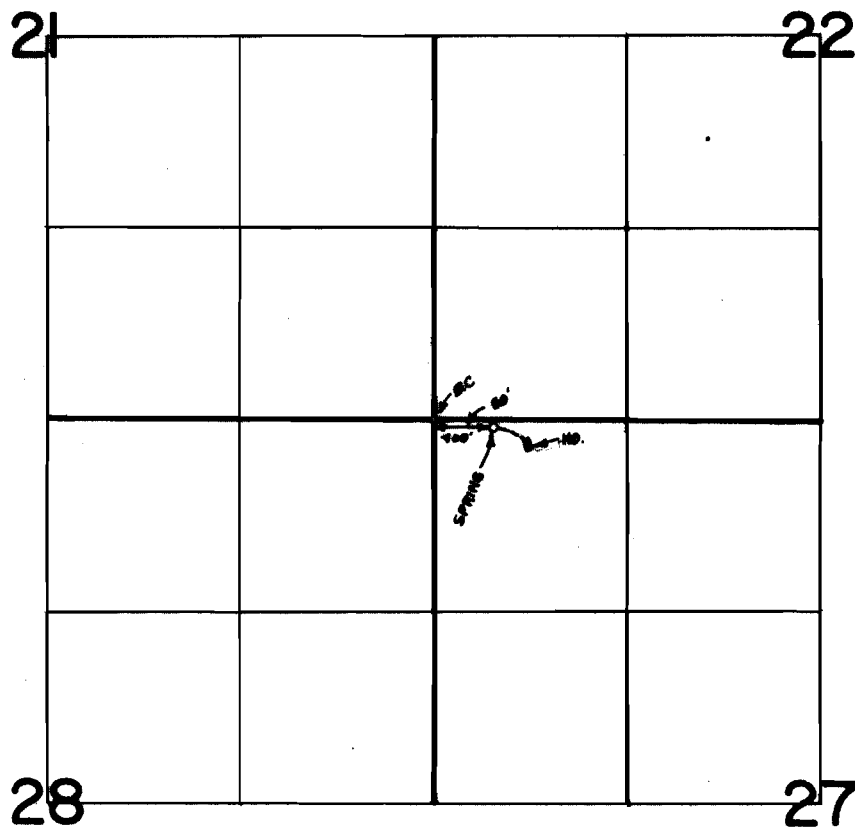

**FINAL PROOF SURVEY**  
UNDER

Application No. 46187 Permit No. 34513  
IN NAME OF

DALE R. & ALICE B. HATCH

Surveyed OCT 10 1973, by R. G. MUCKEN