


T. 36 S. R. 4 W. W.M.

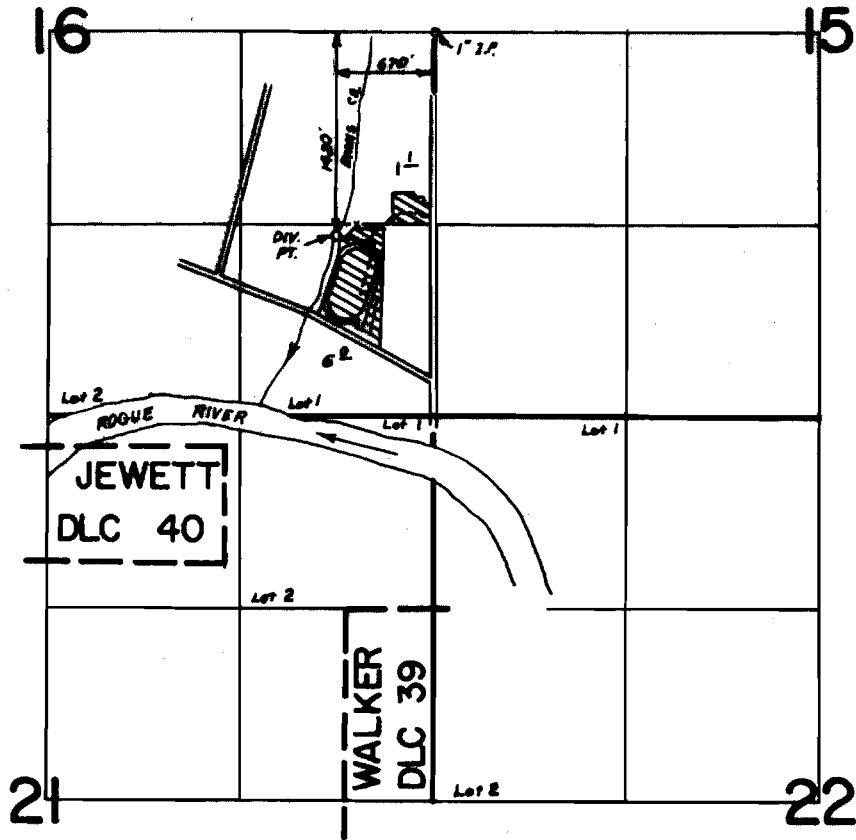

**FINAL PROOF SURVEY  
UNDER**

Application No. 46229 Permit No. 34539  
IN NAME OF

ROGUE RIVER SCHOOL DISTRICT #35

Surveyed OCT 12 1973, by R. G. MUCKEN